

U. S. PUBLIC LAND SURVEY MONUMENT RECORD

INSTRUCTIONS: This record shall show the location of the corner and shall include all of the following nine elements (a through i).

- (a) Identify the corner by reference to the U.S. public land survey system.  
○ = Corner monument restored.

Corner common to Sections 4-5-8-9, T.34N., R.15E., Forest County, Wisconsin.

REGISTER'S OFFICE  
Forest County, Wis.

Received for record this.....day


of.....June.....A. D., 1999, at

8:45.....o'clock.....A.....M. and

recorded in Vol.....CORNER RESTORATIONS

on page.....E-9.....Aschenbrenner

REGISTER

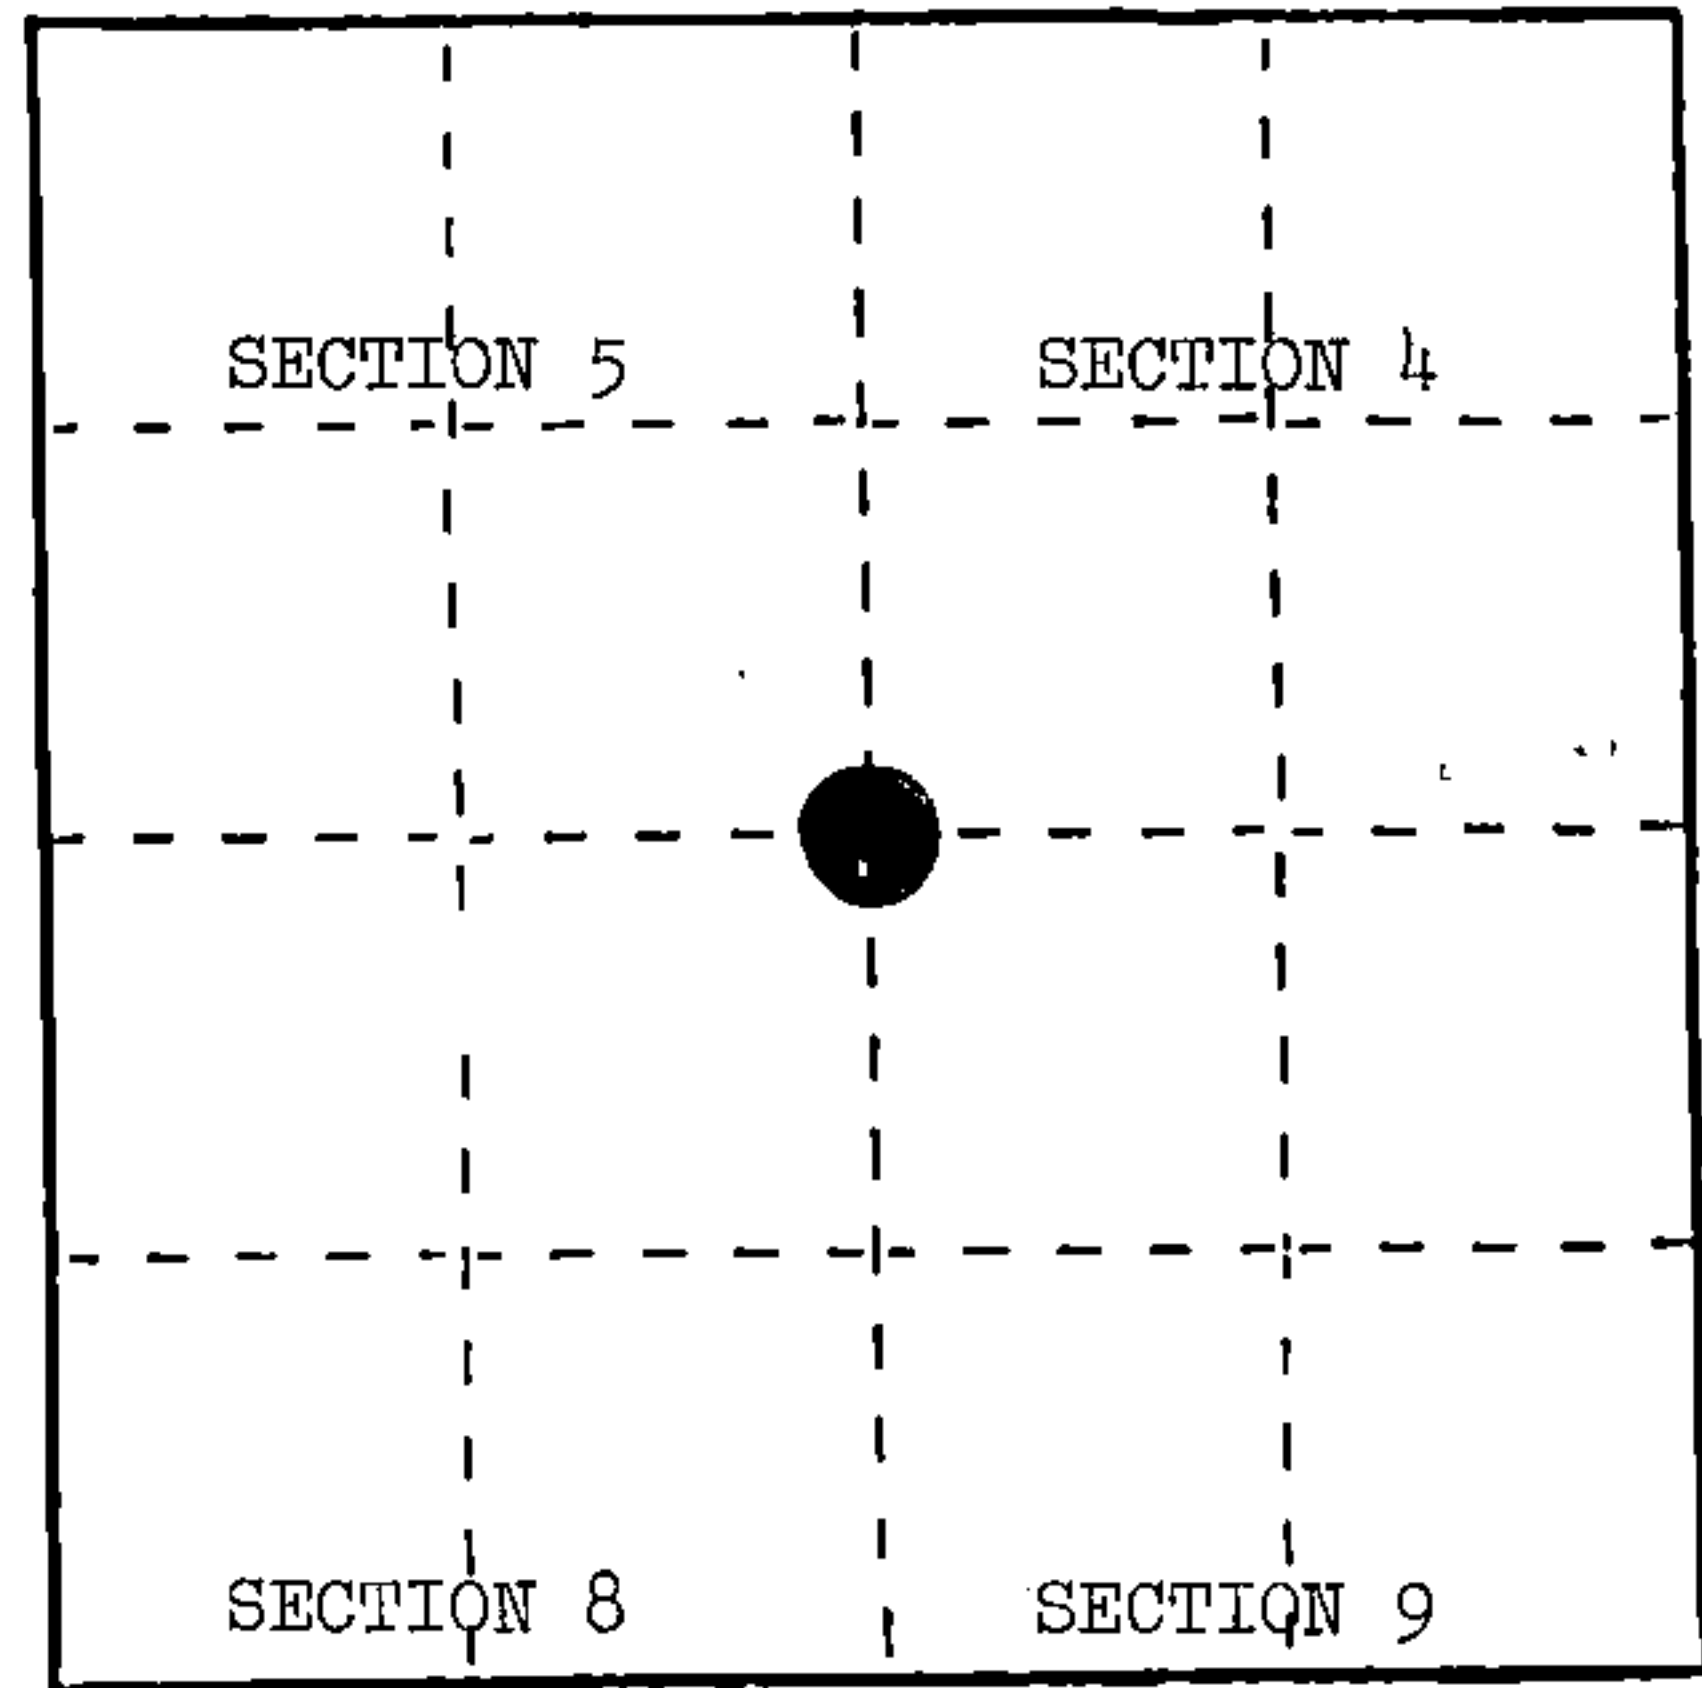

- (b) Describe any record evidence, monument evidence, occupational evidence, testimonial evidence or any other material evidence you considered, and whether the monument was found or placed.

In 1859, J. McBride set wood post for corner and made the following BTs: Elm, 24", N.46°W., 25 links; Elm, 14", N.78°E., 38 links; Sugar, 10", S.7°E., 11 links; Sugar, 8", S.72°W., 39 links.

May, 1905, N. H. Smith found stake for corner.


May, 1908, J. Melendy found Hemlock post by N. Smith. Set new Cedar post, 3½" x 3½" in stones. Fence post at fence corner, N.35½°E., 42¼ links.

April, 1988, Alan Harrison set traverse point at intersections of road centerlines east-north-west. Old fence lines and original evidence has been dozed out. Distance north falls 3.85' long of Melendy's. Position accepted as best evidence of corner location and monumented as such.

- (c) In the plan view drawing below, provide reference ties to at least 4 witness monuments, or, if the location is within a municipality, to at least 2 witness monuments. (Witness monuments shall be made of concrete, natural stone, iron or other equally durable material.)  
Describe witness monuments.

- (d) Show a plan view drawing depicting the relevant monuments and reference ties which is sufficient in detail to enable accurate relocation of the corner monument if the corner monument is disturbed. Indicate north.

- 2½" x 36" aluminum monument in mound of rock stamped to identify the corner.
- Power Pole #3415-9W10, N.23°E., 29.85 feet
- Aspen, 6", S.43°E., 53.89 feet
- Basswood, 6", N.52°W., 65.10 feet
- Steel Sign Post, West, 1.20 feet

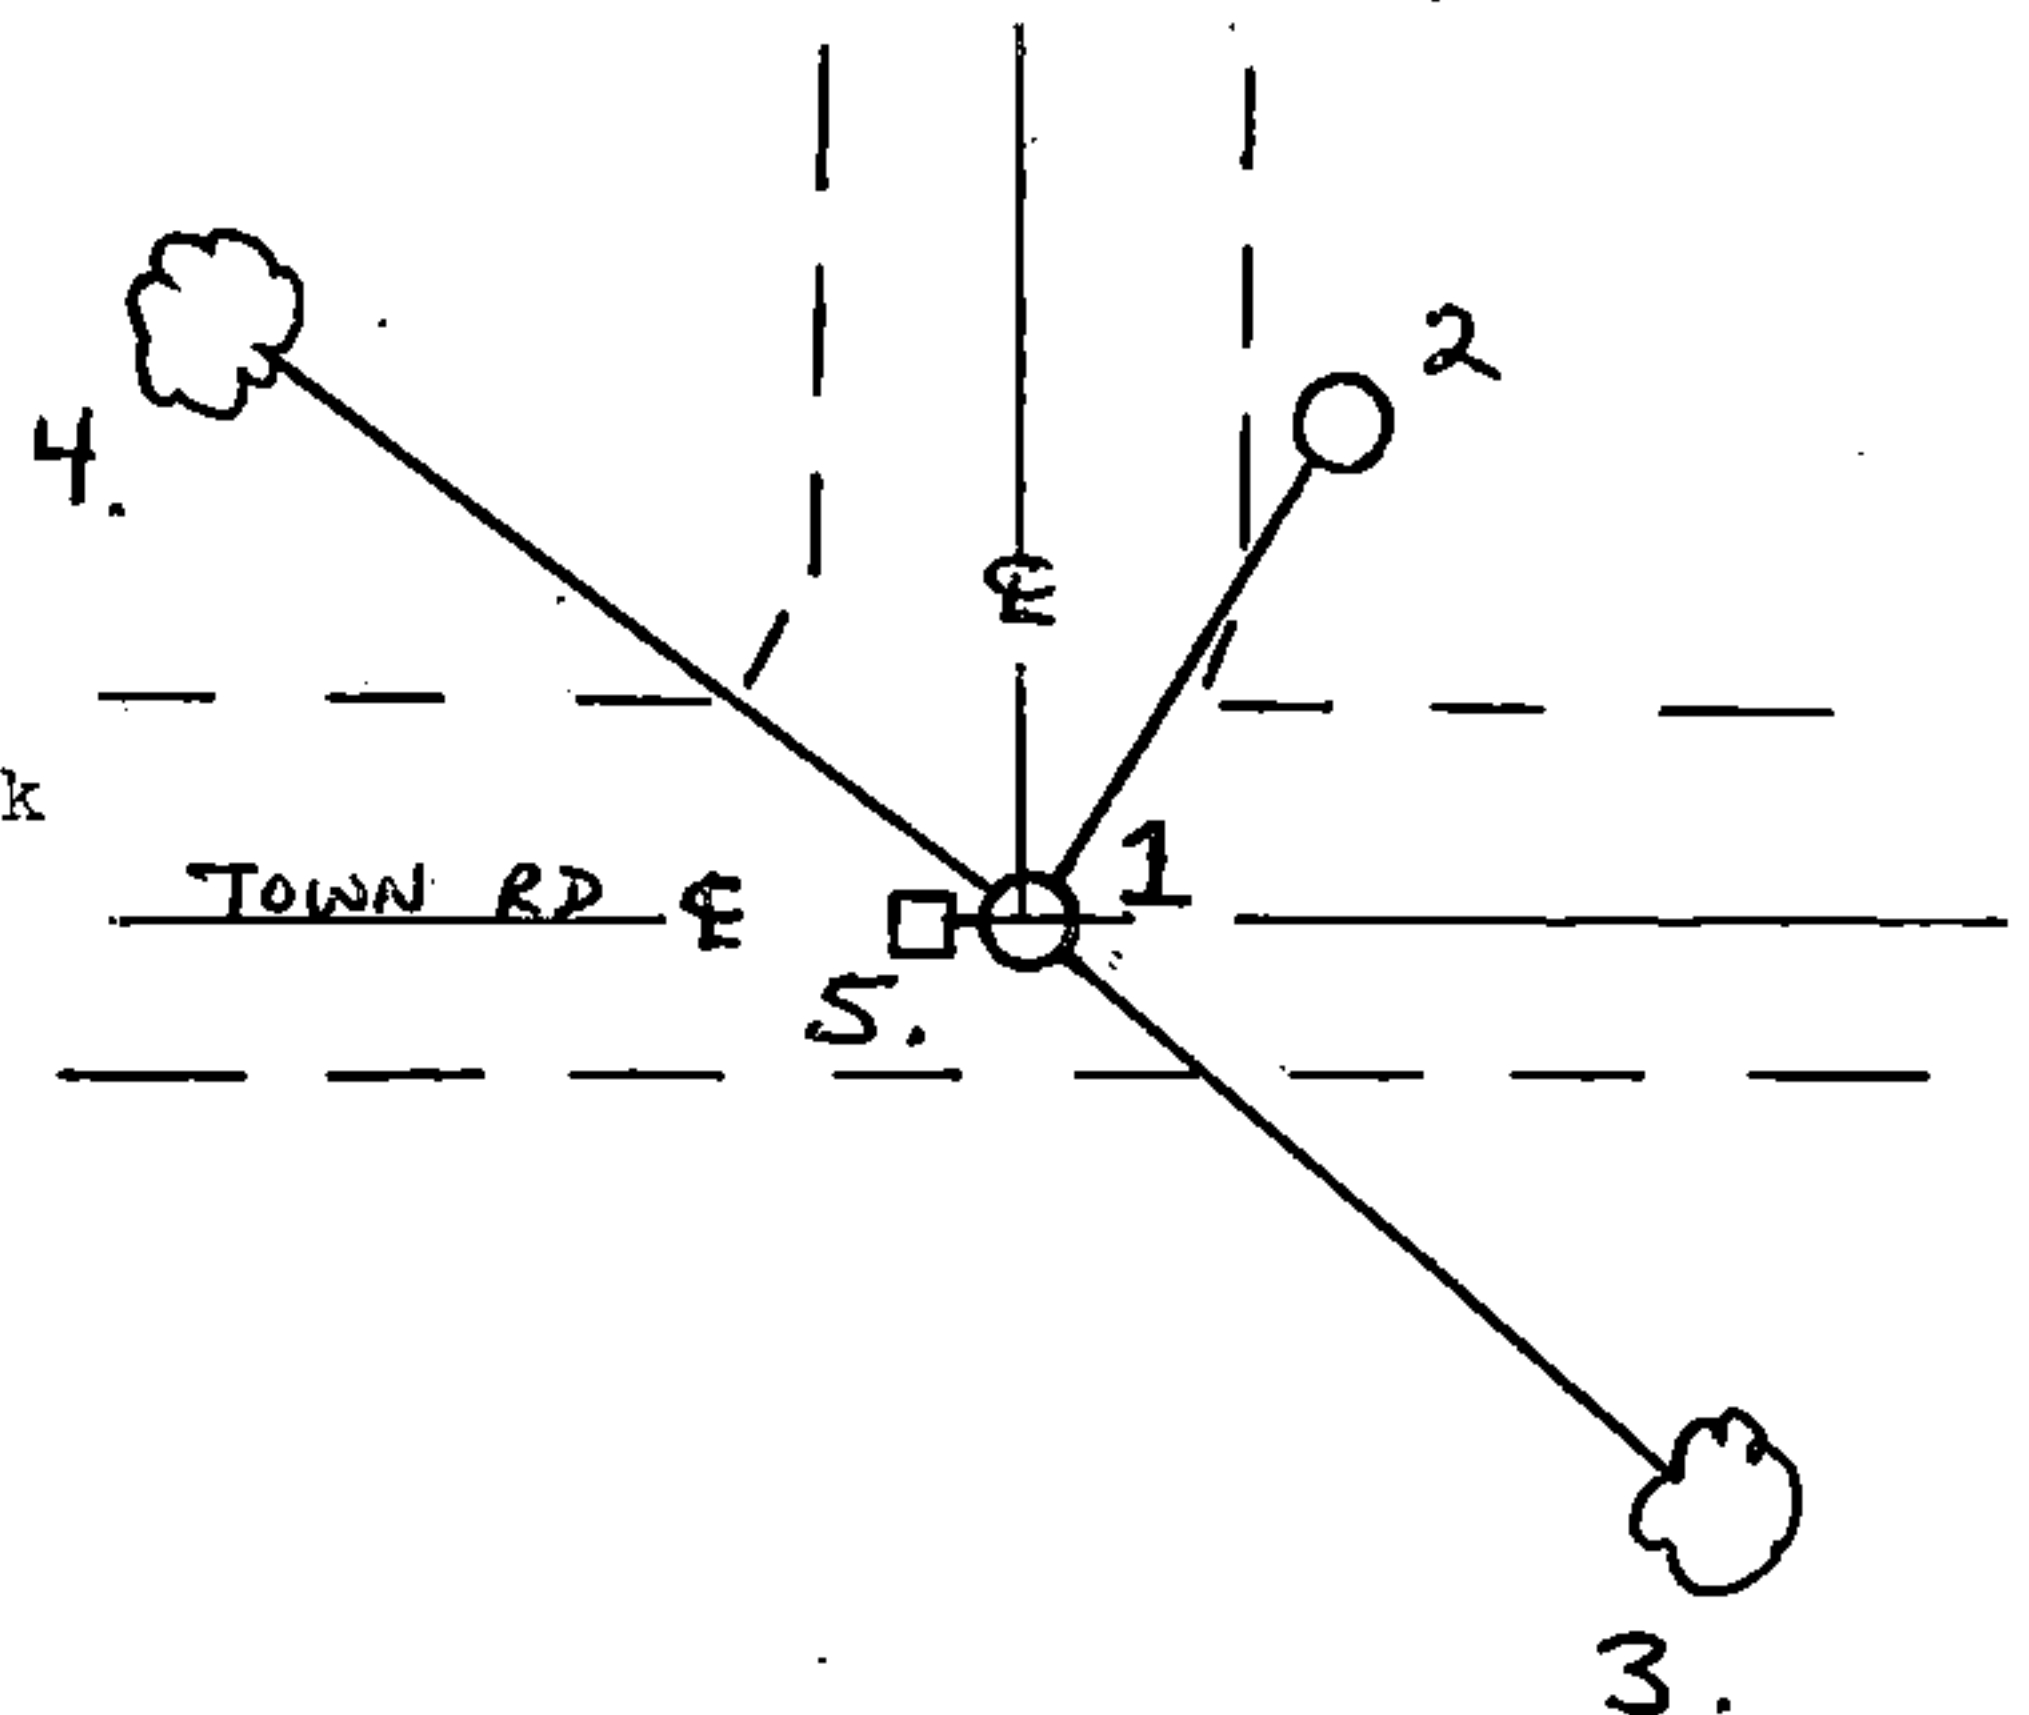

E-9

4341505 0000

E-9

(e) Describe any material discrepancy between the location of the corner as restored or reestablished and the location of that corner as previously restored or reestablished by distance and direction. Show the discrepancy on the plan view drawing under (d), above. Show the distances between the corner as previously restored or reestablished and (1) the corner as restored or reestablished, and (2) to at least 2 of the witness monuments shown on the drawing in (d), above.


Distance north to East  $\frac{1}{4}$  corner, Section 5, by Melendy was 2560.80'. Measure by Forest Service is 2564.65'.

(f) Was the corner restored through acceptance of (1) an obliterated evidence location, or, (2) a found perpetuated location?

(1) an obliterated evidence location.

(g&h) Was the corner reestablished through lost corner proportionate methods? If so, show the method, including the directions and distances to other public land survey corners used as evidence or used for proportioning in determining the corner location?

No.

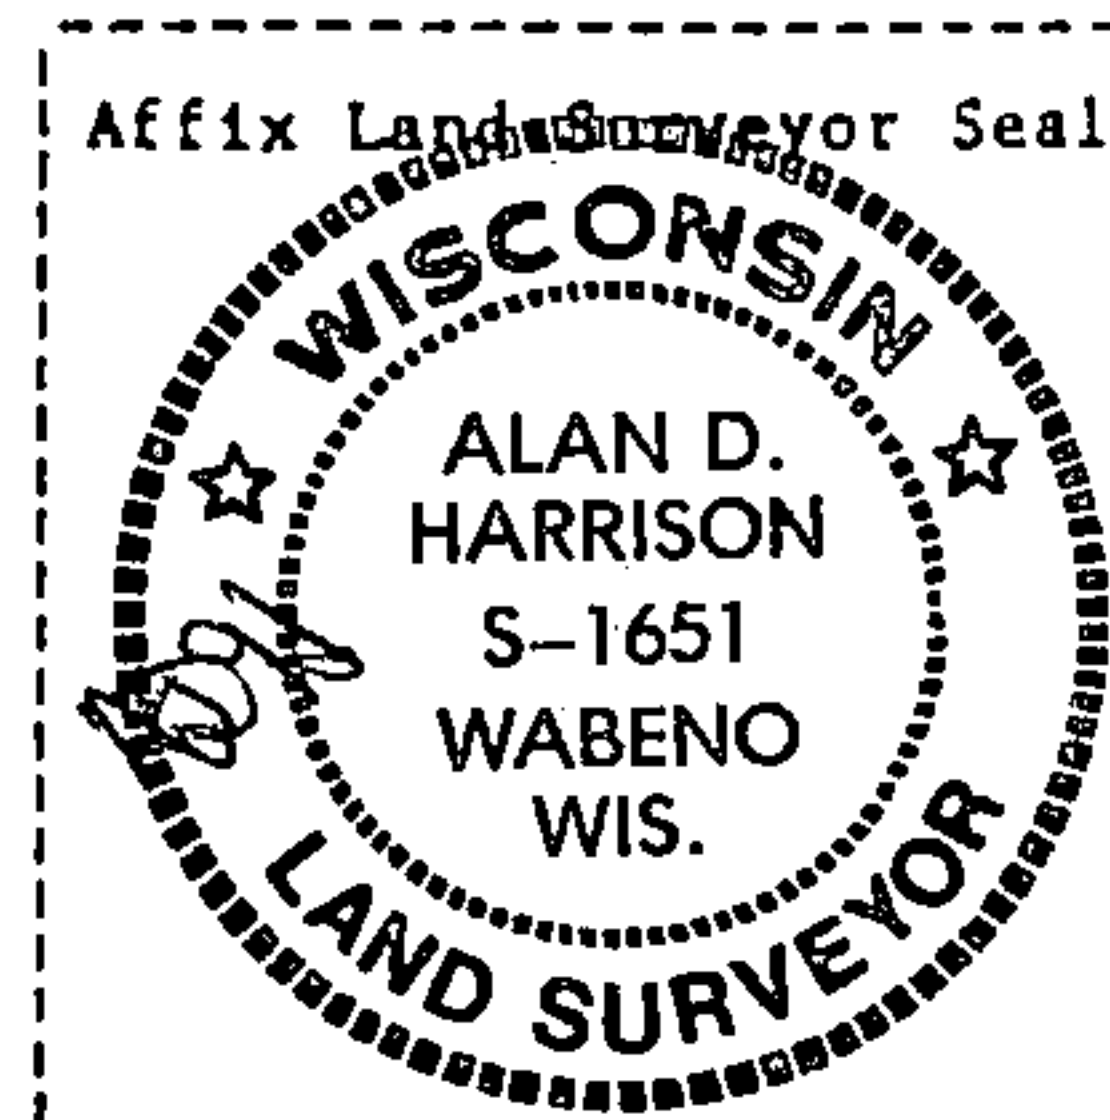

(i) I, Alan D. Harrison  
(Type or print name) certify that the corner location shown on this record was determined by me or under my direction and control and that this U.S. Public Land Survey Monument Record is correct and complete to the best of my knowledge and belief.

Alan D. Harrison 5/31/88  
Signature Date

Certificate ready for filing:

Dale S. Stagg  
District Ranger