


U. S. PUBLIC LAND SURVEY MONUMENT RECORD

INSTRUCTIONS:

This record shall show the location of the corner and shall include all of the following nine elements (a through i).

- (a) Identify the corner by reference to the U.S. public land survey system.
○ = Corner monument restored.

One Quarter Corner common to Sections 19 and 20, T.41N., R.14E., Forest County Wisconsin.

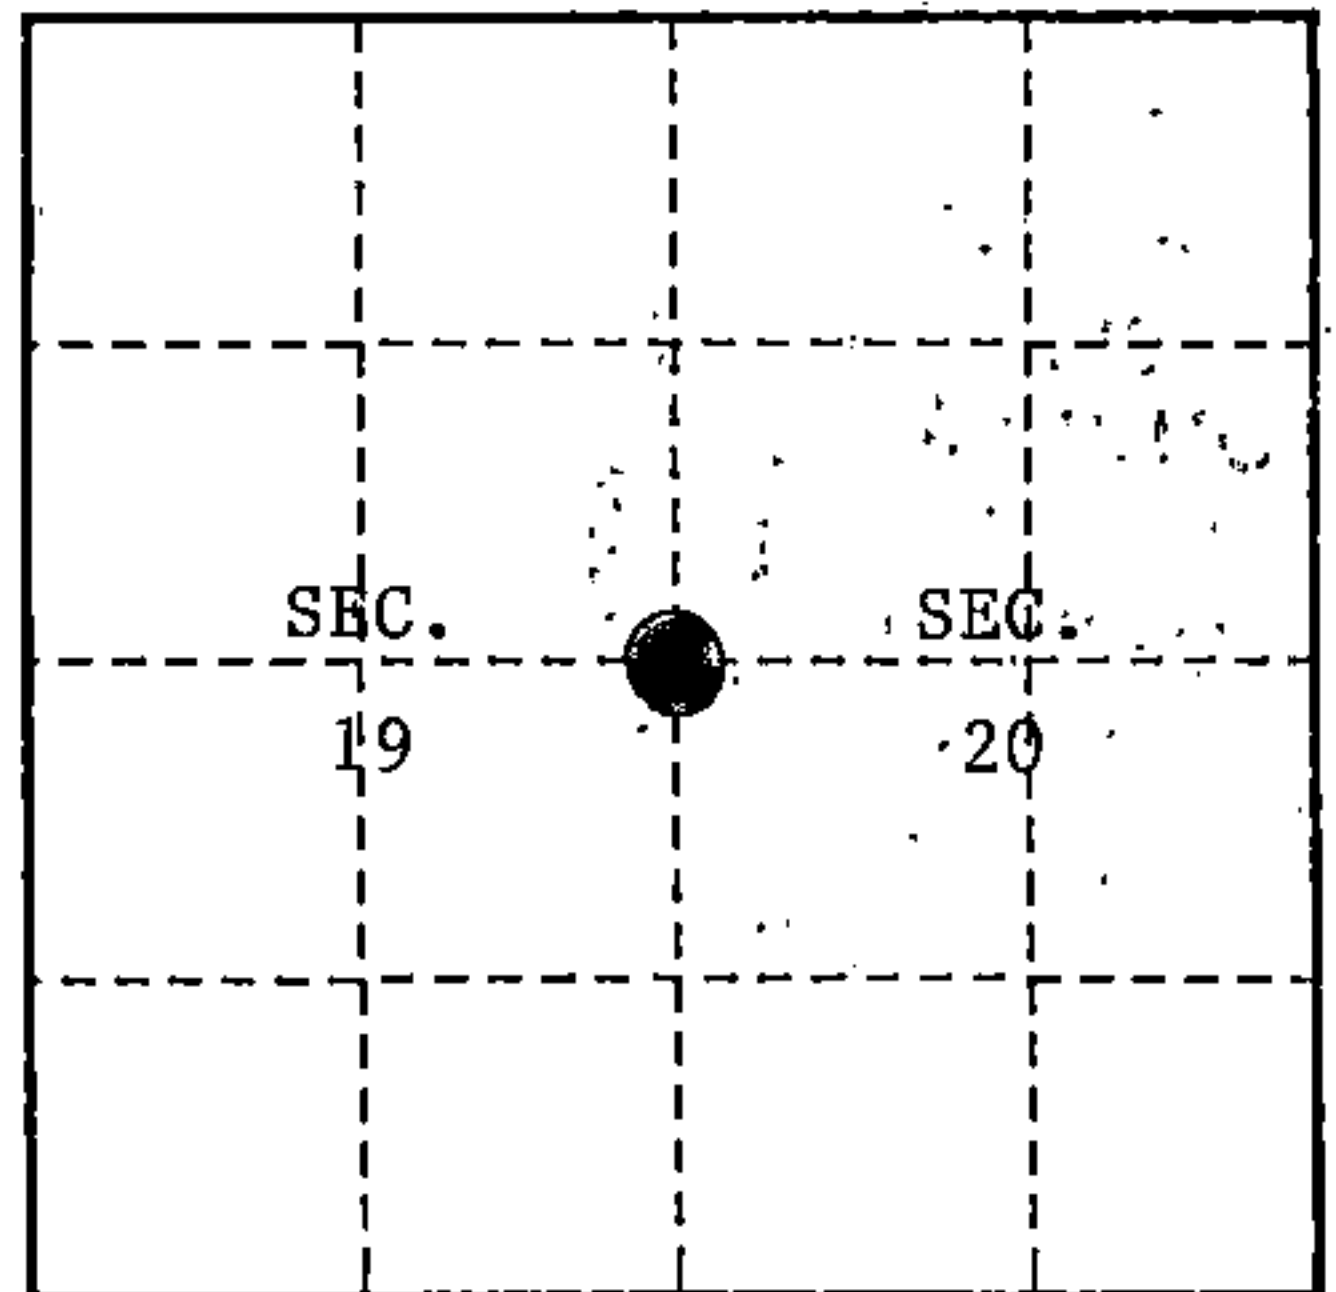

- (b) Describe any record evidence, monument evidence, occupational evidence, testimonial evidence or any other material evidence you considered, and whether the monument was found or placed.

In 1865, William daugherty set 1/4 corner post and made the following references: Birch 8"5 28°E 18 lks (11.88 feet), Yellow Pine 10" N 84°W 23 lks (15.18 feet).

1963 Jean Resvick, R.L.S., restored corner in the intersection of a north-south road with a road running east as the best evidence of corners location. Made the following references: Power Pole #L-35-47-1920 S 16°W 75.57 feet; Power Pole #NT-40-N63-1844 N35°W 36.91 feet.


1998 Alan Harrison, R.L.S., found monument in road intersection, 1 foot below road surface. S.W. powere pole was removed. Set new references as below.

REGISTER'S OFFICE
Forest County, Wis.
Received for record this 24th day
of March A.D., 1999 at
1:15 o'clock P. M. and recorded
in Vol. CORNER RESTORATION
page P-5
Christa Ehlinger
Deputy Register of Deeds

- (c) In the plan view drawing below, provide reference ties to at least 4 witness monuments, or, if the location is within a municipality, to at least 2 witness monuments. (witness monuments shall be made of concrete, natural stone, iron or other equally durable material.)

- (d) Show a plan view drawing depicting the relevant monuments and reference ties which is sufficient in detail to enable accurate relocation of the corner monument if the corner monument is disturbed. Indicate north.

- 1) 6" Concrete Monument with Brass Cap
1 foot below road surface
- 2) Witness Corner 1" x 36" West 30.00 feet
- 3) Red Pine 14' N54°E 63.64 feet
- 4) Power Pole 40-N63-1844 N35°W 36.95 feet
- 5) Steel Sign Post 6' West 30.82 feet

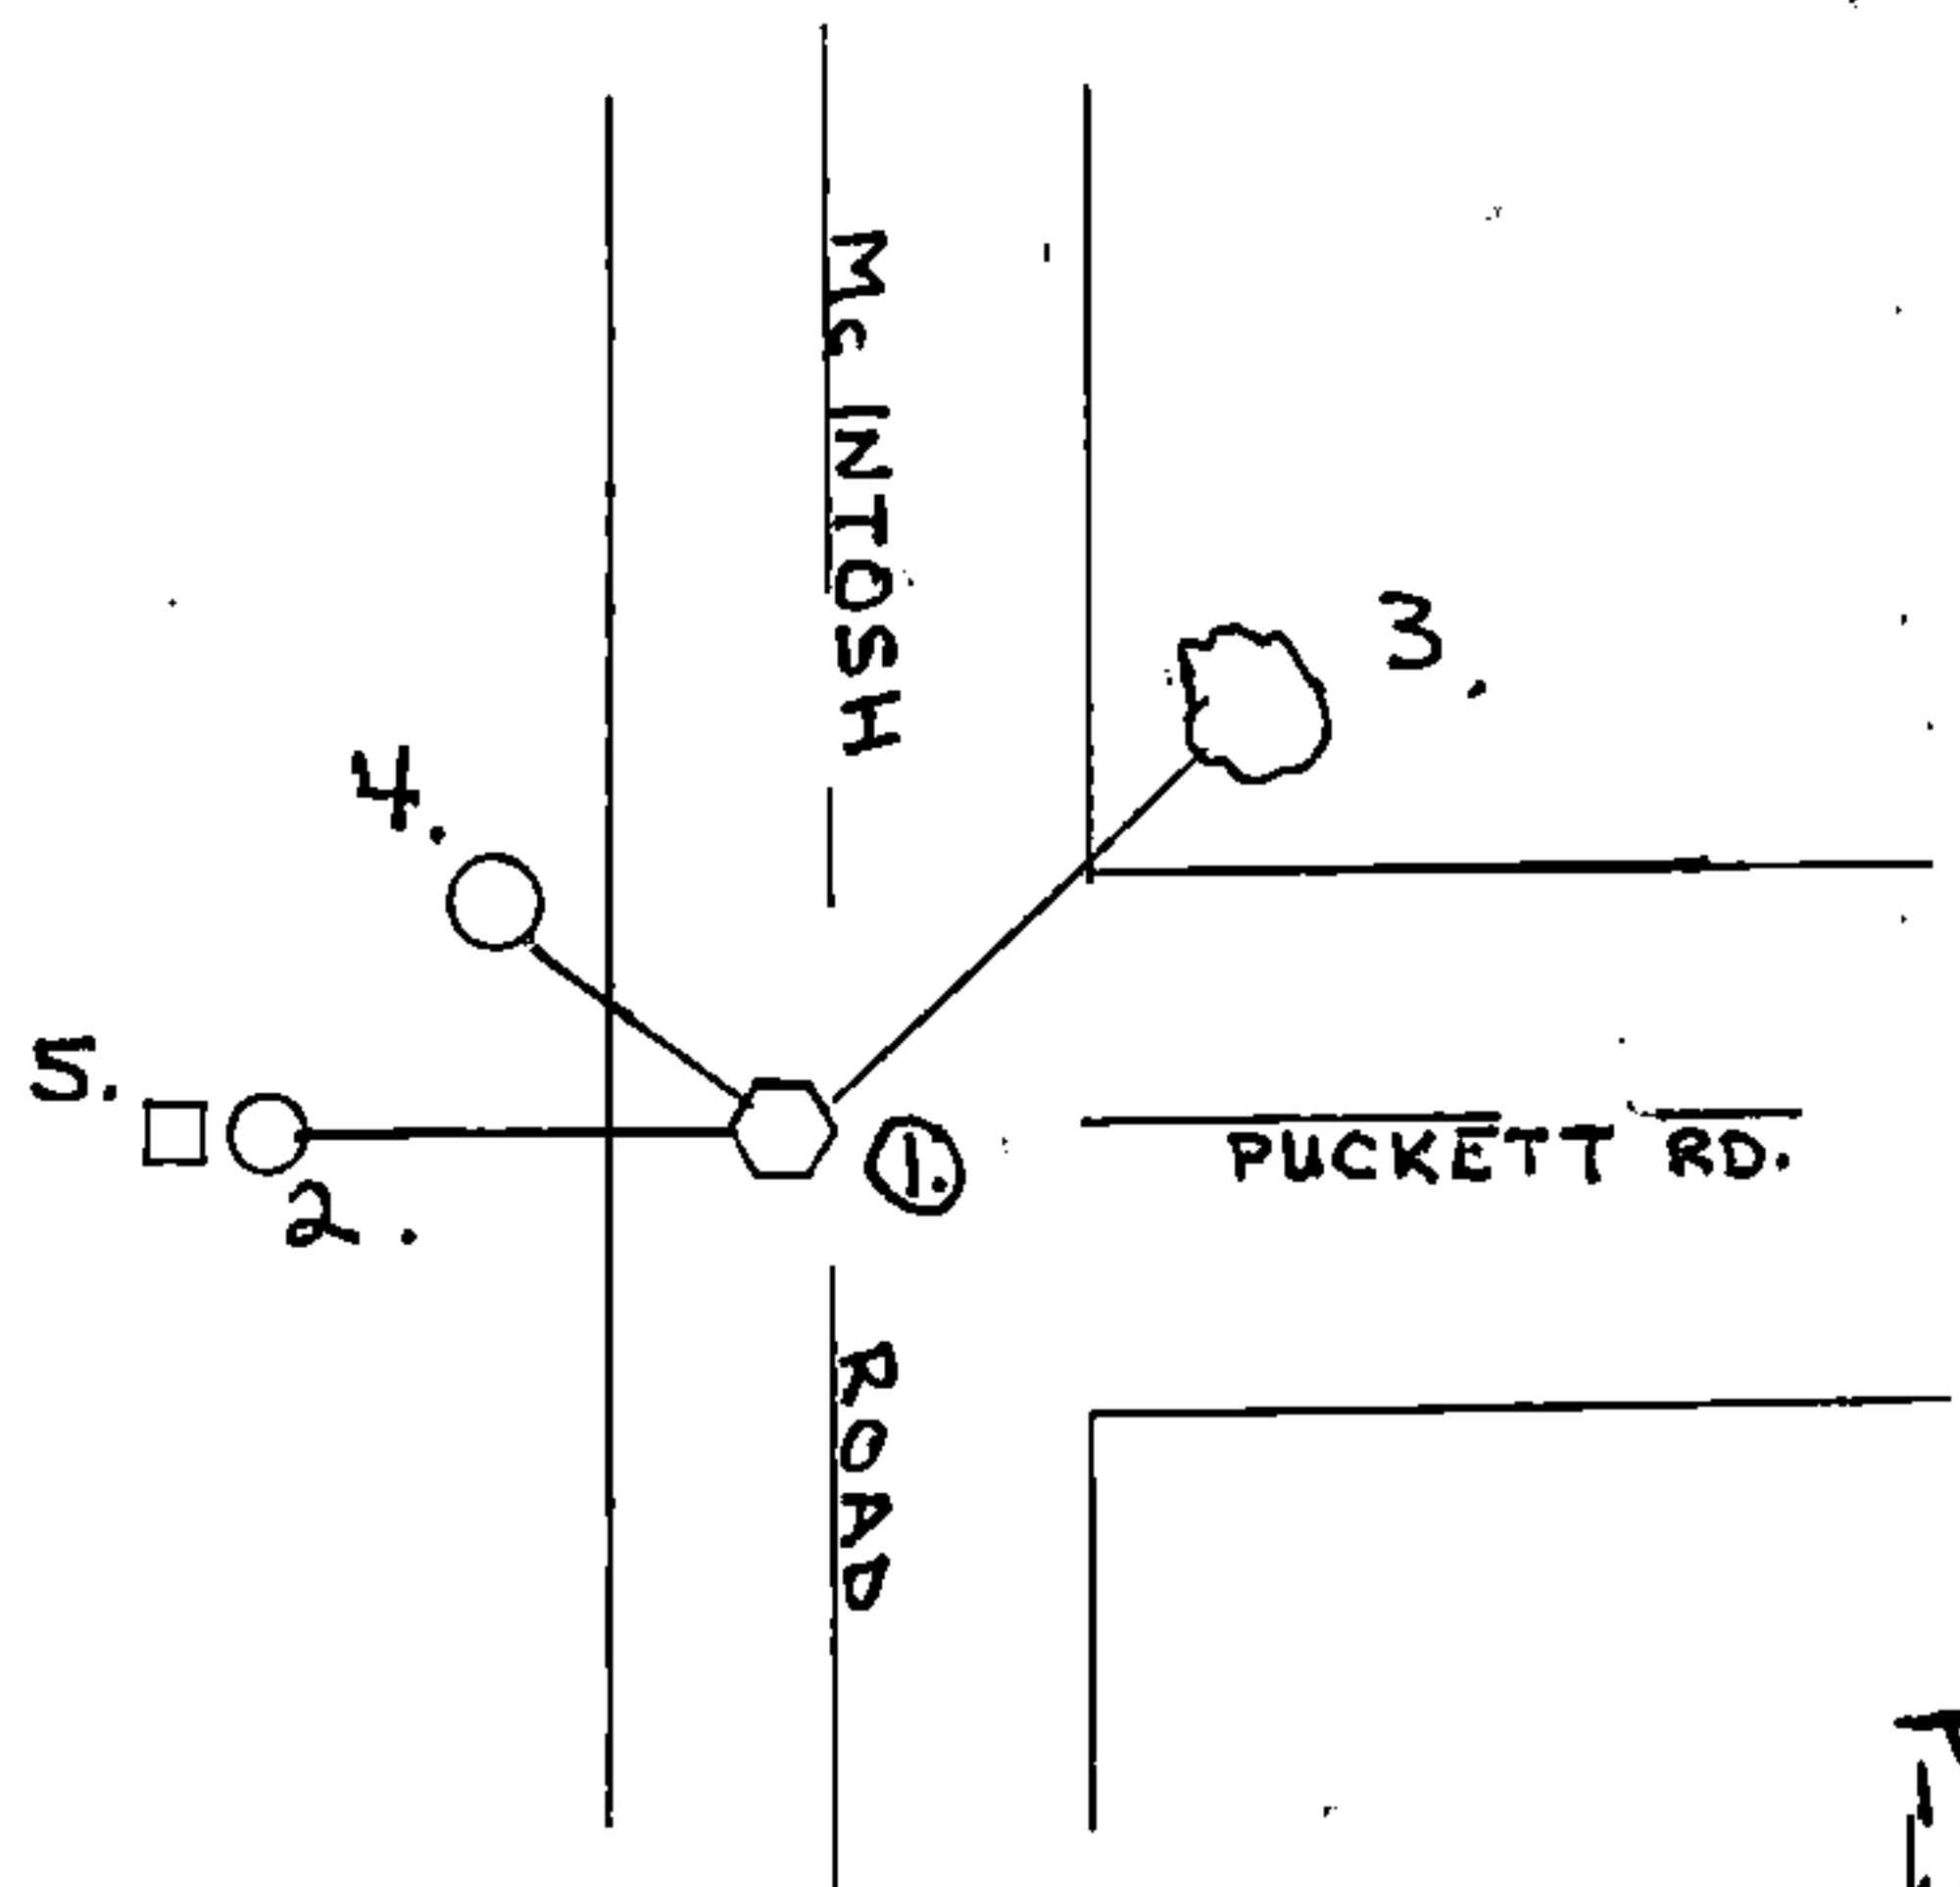

44114 19 2000

P-5

(e) Describe any material discrepancy between the location of the corner as restored or reestablished and the location of that corner as previously restored or reestablished by distance and direction. Show the discrepancy on the plan view drawing under (d), above. Show the distances between the corner as previously restored or reestablished and (1) the corner as restored or reestablished, and (2) to at least 2 of the witness monuments shown on the drawing in (d), above.

none

(f) Was the corner restored through acceptance of (1) an obliterated evidence location, or, (2) a found perpetuated location?

a perpetuated position

(g & h) Was the corner reestablished through lost corner proportionate methods? If so, show the method, including the directions and distances to other public land survey corners used as evidence or used for proportioning in determining the corner location?

no

(1) I, Alan D. Harrison

(type or print name) certify that the corner location shown on this record was determined by me or under my direction and control and that this U.S. Public Land Survey Monument Record is correct and complete to the best of my knowledge and belief.

Alan D. Harrison

Signature

12/21/98

Date

CERTIFICATE READY FOR FILING:

C. B. Tippetts
District Ranger

