

4330903 000 2026

U.S. PUBLIC LAND SURVEY MONUMENT RECORD - LANGLADE COUNTY

Note: This form is intended and designed to fulfill all requirements of Wisconsin Administrative Code, Chapter A-E 7.08 U.S. Public Land Survey Monument Record (3)(a)(b)(c)(d)(e)(f)(g)(h)(i). An additional sheet may be added to if necessary to conform with said requirements.

(a) Corner Location:

Wisconsin Corner ID: 43309030000

Type of Monument: 60D Nail

Location: Southeast Corner

Section 3, Township 33 North, Range 9 East,
Town of Summit, Langlade County, Wisconsin

Langlade County Coordinates NAD83(2011):


Northing: 422615.20

Eastings: 571885.09

RTK GPS direct observation

Calibrated to HMP DP2805 (Summit North GPS)

3 position average on 4/25/2026

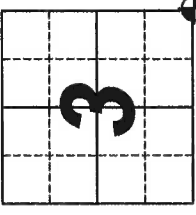


T33N-R9E

I, Chad A. Besaw, Wisconsin Professional Land Surveyor #S3029, hereby certify that the corner location on this record was determined by me and that this U.S. Public Land Survey Monument Record is correct and complete to the best of my knowledge and belief.

Chad A. Besaw


6/11/2026

Date

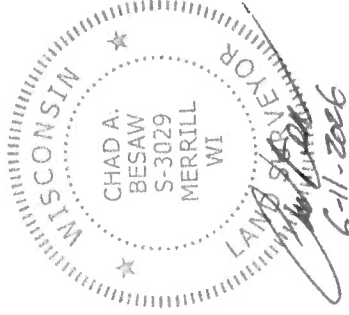

- (b)(f)(g)(h) Description of monument found at this corner and if it was accepted, state all evidence (material, testimonial, occupational, plats, records, other monuments) used as a basis for accepting. If not accepted or if nothing was found, state evidence used as basis for establishing location. If reestablishment through lost corner proportionate methods, indicate all monuments, distances and directions used to establish. Indicate type of monument found or set and sign post.
- ORIGINAL - Sep. 1860-Oct. 1860 - Fellows, H.C. - Set post common to sections 2, 3, 10, 11. Tamarack 15 N28W 23 lks, Spruce 12 S10E 32 lks.
 - April 1898 - B.F. Dorr Old FB 4A page 42, Oneida Co records - at corner.
 - May 1902 - Webley FB 126 page 13 - at corner, found stake set by Dorr, no org BT. Made BT: Pine stump 32 N17.5W, 104 lks.
 - June 1903 - Webley FB 126 page 70 - at corner, Set light gray boulder 10x16x20 + on top.
 - 1921 - Hutchinson - FB 122 page 85 - Stone in road with small stone around it. BT's: Spruce 12 S35W 85.75 lks.
 - Feb. 1938 - Map #40365 - D.A. Hintz shows corner 40.18 chains from E 1/4 section 3 and 39.85 chains from S 1/4 of section 3, 40.97 chains from the S1/4 section 2, 40.00 chains from the E 1/4 section 10.
 - April 1979 - Raymond J Hallisy - Tie Sheet - notes corner set in the 1930 resurvey. 4" Brass Cap, witness corner. Corner sets in cross roads of Highway "T" and town road No trees nearby. Brass Cap is 75lks SW of corner.
 - June 1996 - Dave Tlusty - Tie Sheet - Found nail in the center of the intersection. Returned with M. Kielchski and dug with backhoe. Found 6"x14"x20" red granite boulder with "X" chiseled on top. Stone was found 2.5' below road surface. Accepted stone found as the best evidence of the original corner location. Replaced it with a 1 1/2" x 36" iron pipe with 4" brass cap which is 2.2' below road surface. Made references.
 - July 2004 - CSM V.12 P.031 - Doc. #375673 - Dean Williams set PK nail 2625.45' from N corner of Section 10, and 2637.46' from the E corner of Section 10.
 - Nov. 2007 - CSM V.15 P.007 - Doc. #398158 - Dean Williams found PK Nail 2625.46' from the N corner of Section 10, and 2637.47' from the E corner of Section 10.
 - May 2020 - Map #11034 - Timothy Rusch found PK Nail 2707.00' from S 1/4 section 2, and 3649.54' from W 1/4 section 2.
 - Sep. 2020 - CSM V.19 P.120 - Doc. #455125 - Charley Brinkmeier found a Mag Nail 2625.48' from the S corner of Section 3, and 2649.76' from the E corner of section 3.
 - Nov. 2020 - Map #20216 - Jason Pflieger found mag spike 2625.56' from N 1/4 corner of sec 10.
 - 4/25/2026 - Chad Besaw - Found 60D Nail at corner location. Nail fit well with Tlusty's 1996 ties and record distance West. Made new references.

(c)(d)(e) Plan view of corner with ties to at least 4 witness monuments. If in disagreement with previously established corner, show the distances between the two corners and also indicate the ties to the disputed corner.

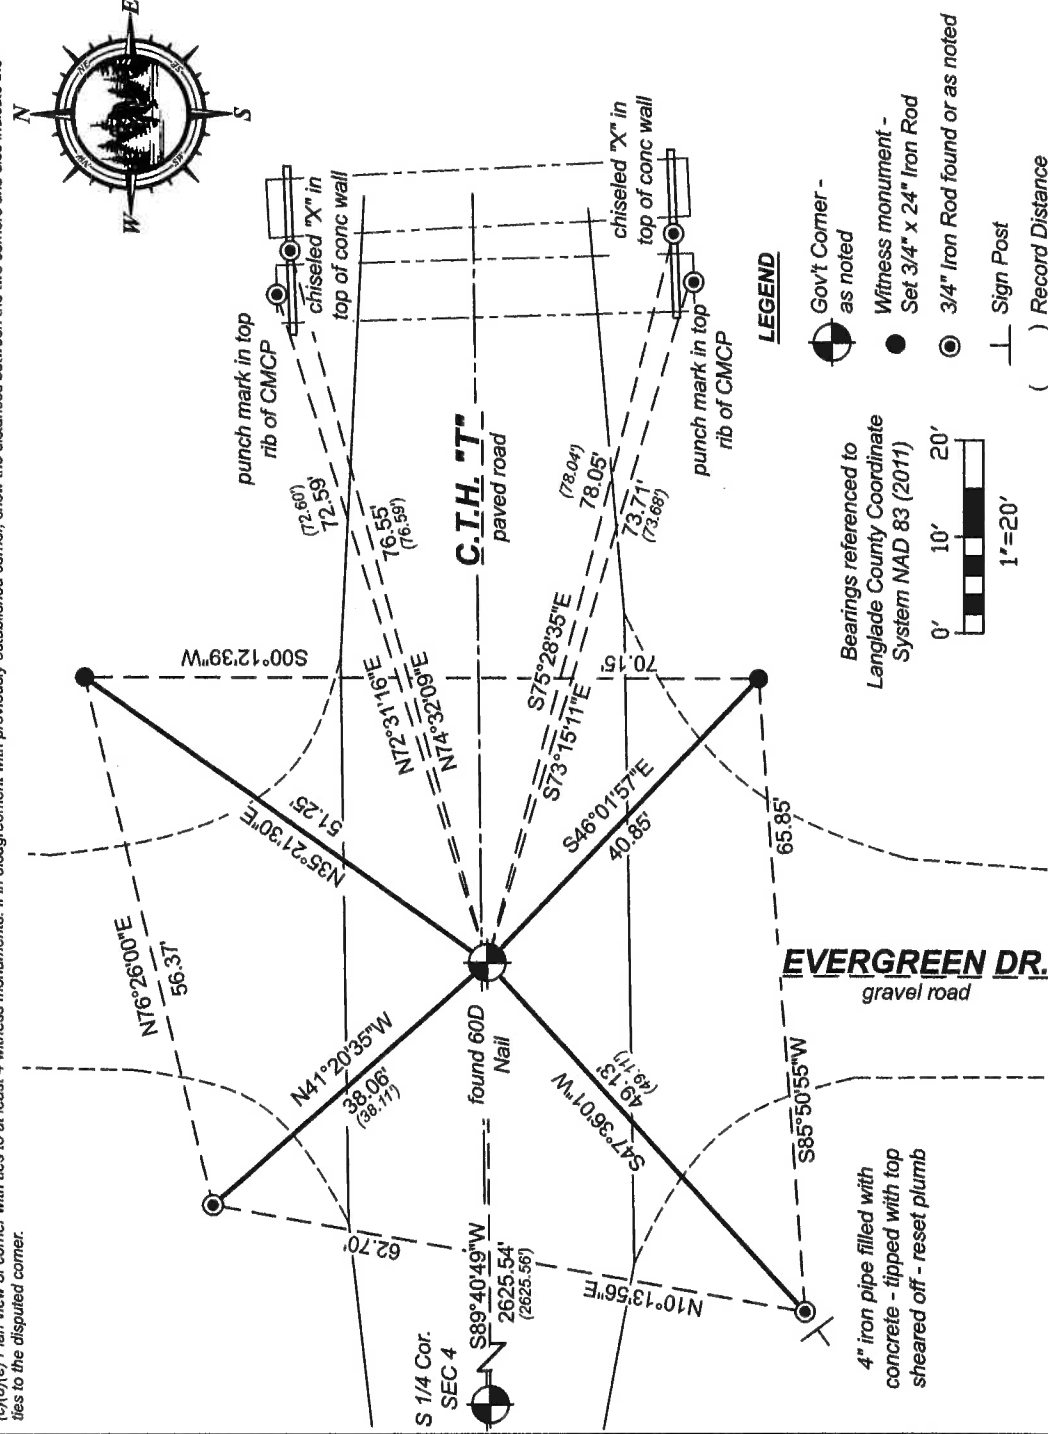

E17 33-09


U. S. PUBLIC LAND SURVEY MONUMENT RECORD

INSTRUCTIONS:

This record shall show the location of the corner and shall include all of the following nine elements (a through i).


- (a) Identify the corner by reference to the U.S. public land survey system.
O = Corner monument restored.

The Southwest corner of
Section 2,
Township 33 North,
Range 9 East,
Langlade County,
Wisconsin.

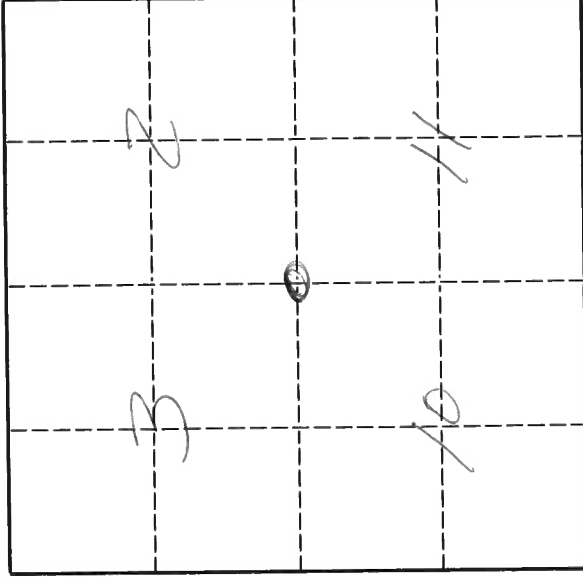

T. 33 N., R. 9 E.

- (b) Describe any record evidence, monument evidence, occupational evidence, testimonial evidence or any other material evidence you considered, and whether the monument was found or placed.
- The original corner was established in 1860 by H.C. Fellows. Original BT's: tamarac, 15", N28°W, 23 lks., spruce, 12", S10°E, 32 lks. In 1921, Malcolm Hutchinson described the corner as a stone in road, small stones around it. He marked a spruce, 12", S35°W, 85 3/4 lks. The 1930's resurvey either found the corner or established it and set 4" iron pipe with brass cap witness 75 lks southwest, but I have no notes to know what was found or set for the actual corner. In 1979, Ray Hallisy found and made witness's to the 1930's witness monument. 06/07/96 D. Tlusty found a nail in the center of the intersection. 06/11/96 D. Tlusty, M. Kielcheski dug with backhoe, found 6" x 14" x 20" red granite boulder with "X" chiseled on top. (con't. on reverse)
- (c) In the plan view drawing below, provide reference ties to at least 4 witness monuments, or, if the location is within a municipality, to at least 2 witness monuments. (Witness monuments shall be made of concrete, natural stone, iron or other equally durable material.)
Describe witness monuments.

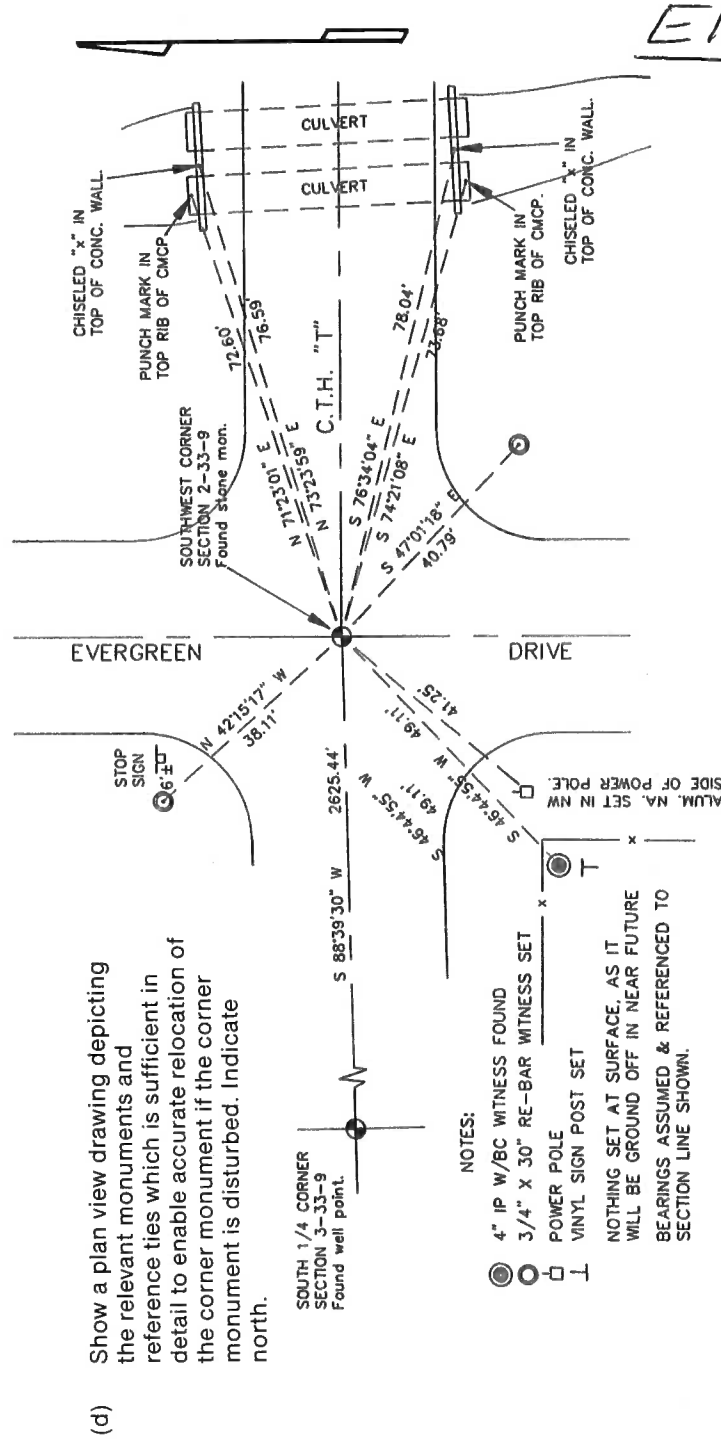


Describe any material discrepancy between the location of the corner as restored or reestablished and the location of that corner as previously restored or reestablished by distance and direction. Show the discrepancy on the plan view drawing under (d), above. Show the distances between the corner as previously restored or reestablished and (1) the corner as restored or reestablished, and (2) to at least 2 of the witness monuments shown on the drawing in (d), above.

No discrepancy.

- (f) Was the corner restored through acceptance of (1) an obliterated evidence location, or, (2) a found perpetuated location?
A found perpetuated location.

- (g & h) Was the corner reestablished through lost corner proportionate methods? If so, show the method, including the directions and distances to other public land survey corners used as evidence or used for proportioning in determining the corner location.
No.

(continued from front side)
Stone found 2.5' below road surface. Accepted stone found as the best evidence of the original corner location. Replaced it with a 1½" x 36" iron pipe with 4" brass cap which is 2.2' below road surface.

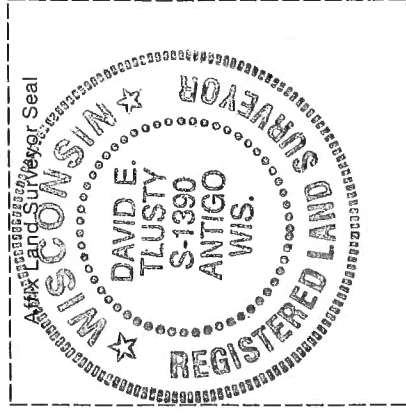

- (i) David E. Tlusty,
Langlade County Surveyor
(type or print name)


certify that the corner location shown on this record was determined by me or under my direction and control and that this U.S. Public Land Survey Monument Record is correct and complete to the best of my knowledge and belief.

David E. Tlusty 7/15/96
Signature Date

State of Wisconsin }
County of Langlade } ss.

I Raymond J. Hallisy, do hereby
certify that on the 8th day
of April, 1979, I found
evidence of the Section
corner of 2, 3, 10, & 11
Township 33, North, Range
9E, Fourth Principal Meridian,
as described hereon; and that from this evidence
I established a new monument and accessories
as described hereon to perpetuate the original
location of this corner.

Resident witnesses:

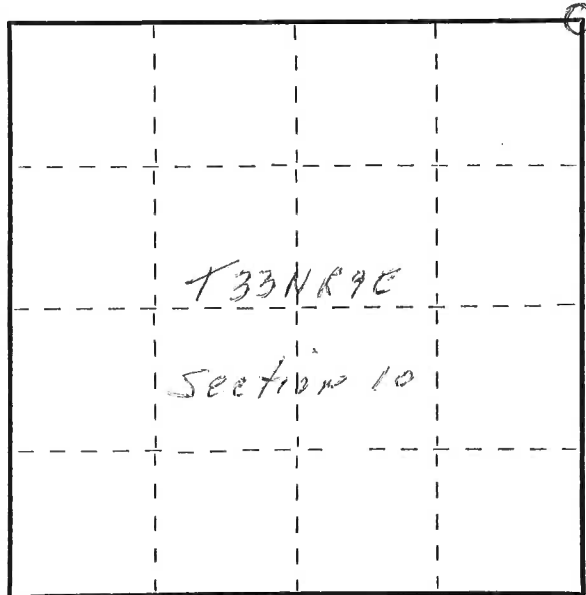

○ = Corner monument restored.

CERTIFIED LAND CORNER RESTORATION

Index No. E-17

History of original corner establishment:

Corner set in the 1930 resurvey.

Description of corner evidence found:


4" pipe with brass cap, witness corner.
Corner sets in cross roads of Hiway "T" and town road. No trees nearby.

Description of monument and accessories I established to perpetuate the original location of this corner.

B.O's to witness Corner.

Light pole	N77E	8' 10"
Fence Corner	N47E	2' 10"
X on culvert	S6E	100' 3"

Rock Mound

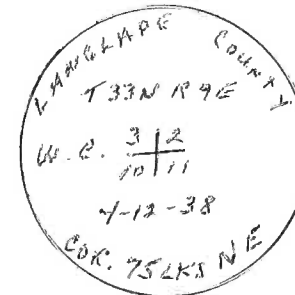

Dated at Antigo, Wis., this 8th day of April, 1979.

Signature Raymond J. Hallisy Title Reg. Surveyor Registration No. S-685
(County Surveyor, Registered Land Surveyor, or other duly authorized official)

Office of Register of Deeds, County of _____, I hereby certify that the within
instrument was filed in this office for record on the _____ day of _____, 19____
at _____ o'clock _____ M.

(Register of Deeds)

By _____ Deputy