

CERTIFIED LAND CORNER RESTORATION

State of Wisconsin }
County of Forest } ss.

I Jean F. Resvick, do hereby certify that on the 24 day of September, 1979, I found evidence of the West Quarter corner of Section 8 Township 36 North, Range 15 East, Fourth Principal Meridian, as described hereon; and that from this evidence I established a new monument and accessories as described hereon to perpetuate the original location of this corner:

Description of original monument and accessories and subsequent restorations:

Surveyed in 1859 by James McBride
40 chains north between Sections 7 and 8, set post
Sugar 16, S87E, 21 lks.
Sugar 15, S40W, 25 lks.



Description of corner evidence found:

Iron pipe, 1.45 feet long, 1.7 feet below surface of road.
Top of iron pipe near natural surface of ground with 1.7 feet of road fill.
Fence line runs east.
Pipe appears to have been in place when road was built as Highway 8.

Description of monument and accessories I established to perpetuate the location of this corner:

Replaced iron pipe with 2 inch inside diameter galvanized iron pipe,
3 feet long, filled with concrete, 0.4 feet below surface of road,
with brass cap stamped T36N, R15E, 1/4, S7, S8, 1979, S-802

No bearing trees available
Placed iron pipe found north of monument in hole.

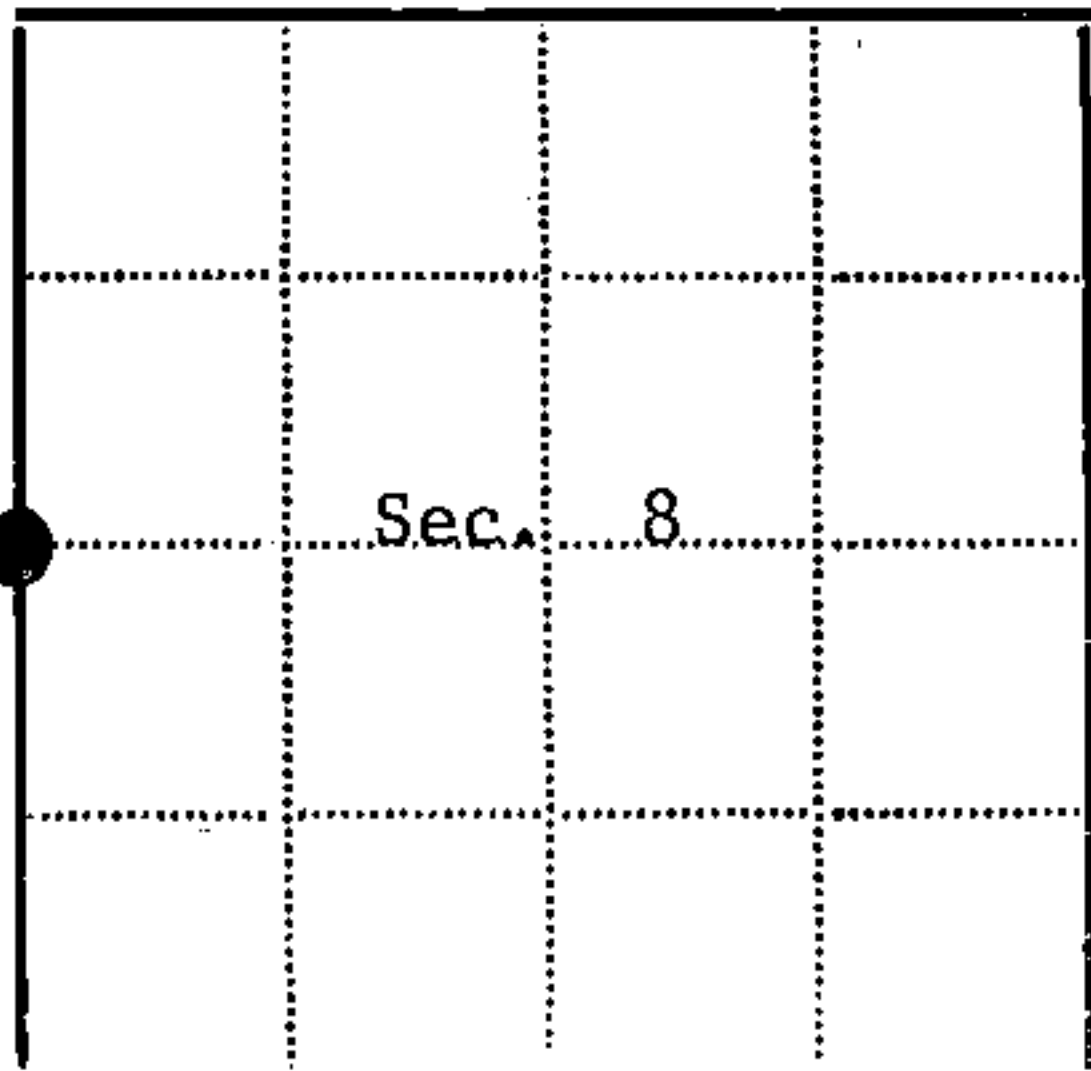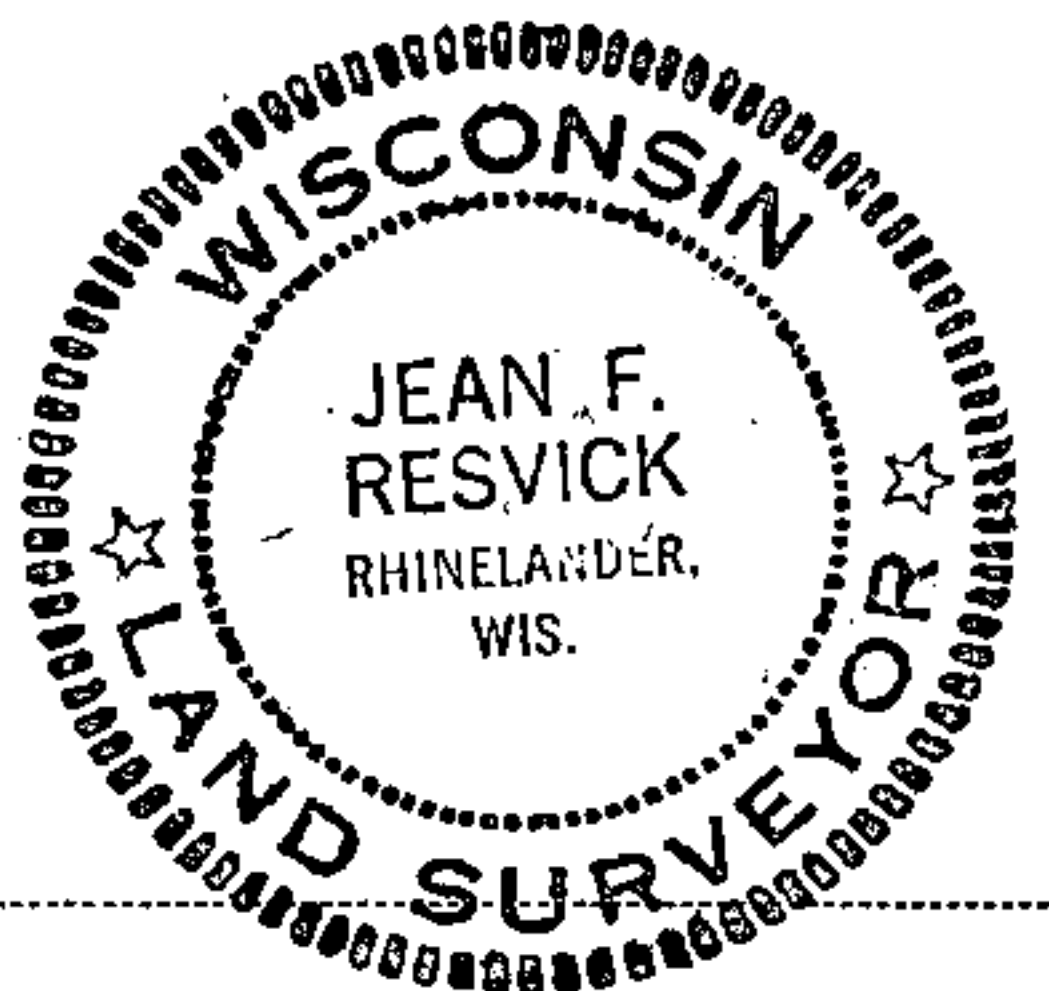

● - Corner monument restored
□ -

Resident witnesses.....

Dated at Rhinelander Wisconsin, this 25 day of September 1979.

Signature *Jean F. Resvick* Title Land Surveyor
(County Surveyor, Registered Land Surveyor, or other duly authorized official)

Surveyors Registration No. S-802 DOCUMENT NO. 118068

Office of Register of Deeds County of Forest

I hereby certify that the within instrument was filed in this office for record on the 9th day of June 1980, and was filed in Book No. Page No. of County Records.

Signature *Sharon Mueller* Title Deputy

Township 36 North, Range 15 East, Section 8, Index No. G-5, Page No.

43615072000

5