


U. S. PUBLIC LAND SURVEY MONUMENT RECORD

INSTRUCTIONS: This record shall show the location of the corner and shall include all of the following nine elements (a through i).

- (a) Identify the corner by reference to the U.S. public land survey system.
 ○ = Corner monument restored.

Corner to Sections 4, 5, 32, and 33, T.36-37N., R.15E.

REGISTER'S OFFICE
 Forest County, Wis.
 Received for record this 3rd day
 of December A.D., 1986 at
1:30 o'clock P.M. and recorded
 in Vol. CORNER RESTORATIONS
 page A-9
Paul Aschenbrenner
 Register of Deeds

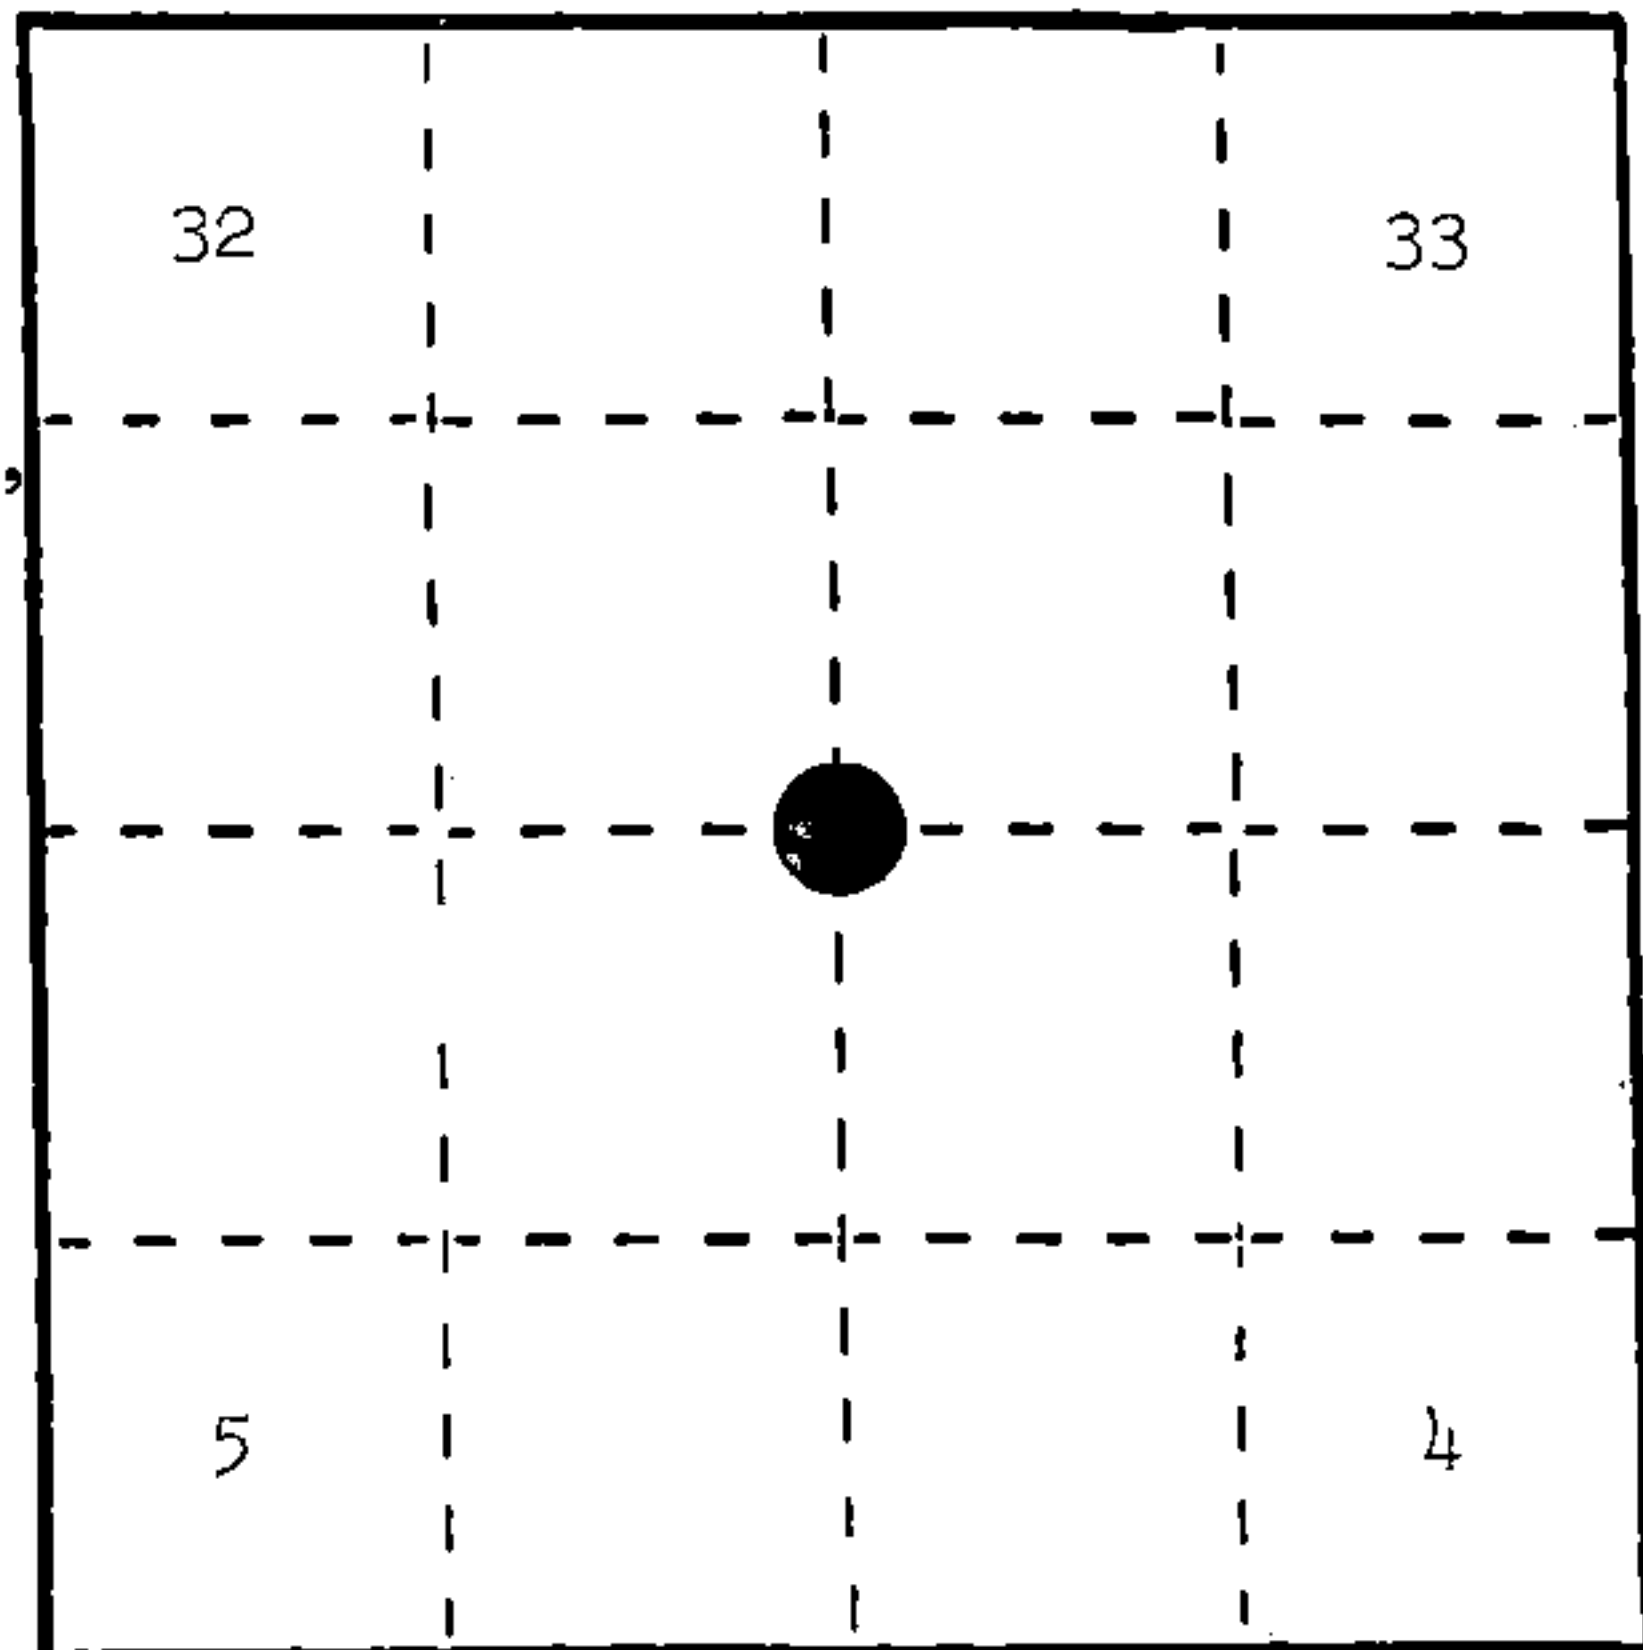

- (b) Describe any record evidence, monument evidence, occupational evidence, testimonial evidence or any other material evidence you considered, and whether the monument was found or placed.

In 1857, Artemas Curtis set a wood post and made the following BTs: Spruce, 10", N.02°E., 28 links; Cedar, 6", S.39°E., 44 links; Aspen, 12", S.30°W., 31 links; Aspen, 8", N.29°W., 31 links.


In 1911, J. J. Melendey found the following: Aspen, 16", S.27¼°W., 31 links; Cedar, 11", S.39½°E., 44 links; Spruce stump, 12", N.01 3/4°E., 26 2/3 links. Set a 5" x 5" Cedar post and added the following BTs: Birch, 8", N.45¼°W., 54 4/10 links; Birch, 14", S.45¼°W., 41 1/8 links.

In 1981, Milo Stefan found out a road was put over the corner location (late 1910s). Found no BTs of either original or subsequent survey. In 1985, Stefan had backhoe dig up road in surveyed position for corner and found Melendey's BTs and original BTs cut off and buried in road. Also found original piece of post and cut off post point to Melendey's 5" x 5' post. Further digging with a shovel produced a circular pile of rocks under post point and the other evidence found. Set monument in center of rock pile and made new references;

- (c) In the plan view drawing below, provide reference ties to at least 4 witness monuments; or, if the location is within a municipality, to at least 2 witness monuments. (Witness monuments shall be made of concrete, natural stone, iron or other equally durable material.)
 Describe witness monuments.

- (d) Show a plan view drawing depicting the relevant monuments and reference ties which is sufficient in detail to enable accurate relocation of the corner monument if the corner monument is disturbed. Indicate north.

1. 2" x 30" aluminum monument stamped to identify the corner location.
2. Cedar, 8", N.54°E., 44.09 feet
3. Cedar, 8", S.82°E., 38.51 feet
4. Boulder, 3'x3'x4', S.84°W., 43.30 feet
5. Power Pole, #3715-32R1, N.33°W., 64.88 feet
6. Steel Sign Post, East, 13.8 feet

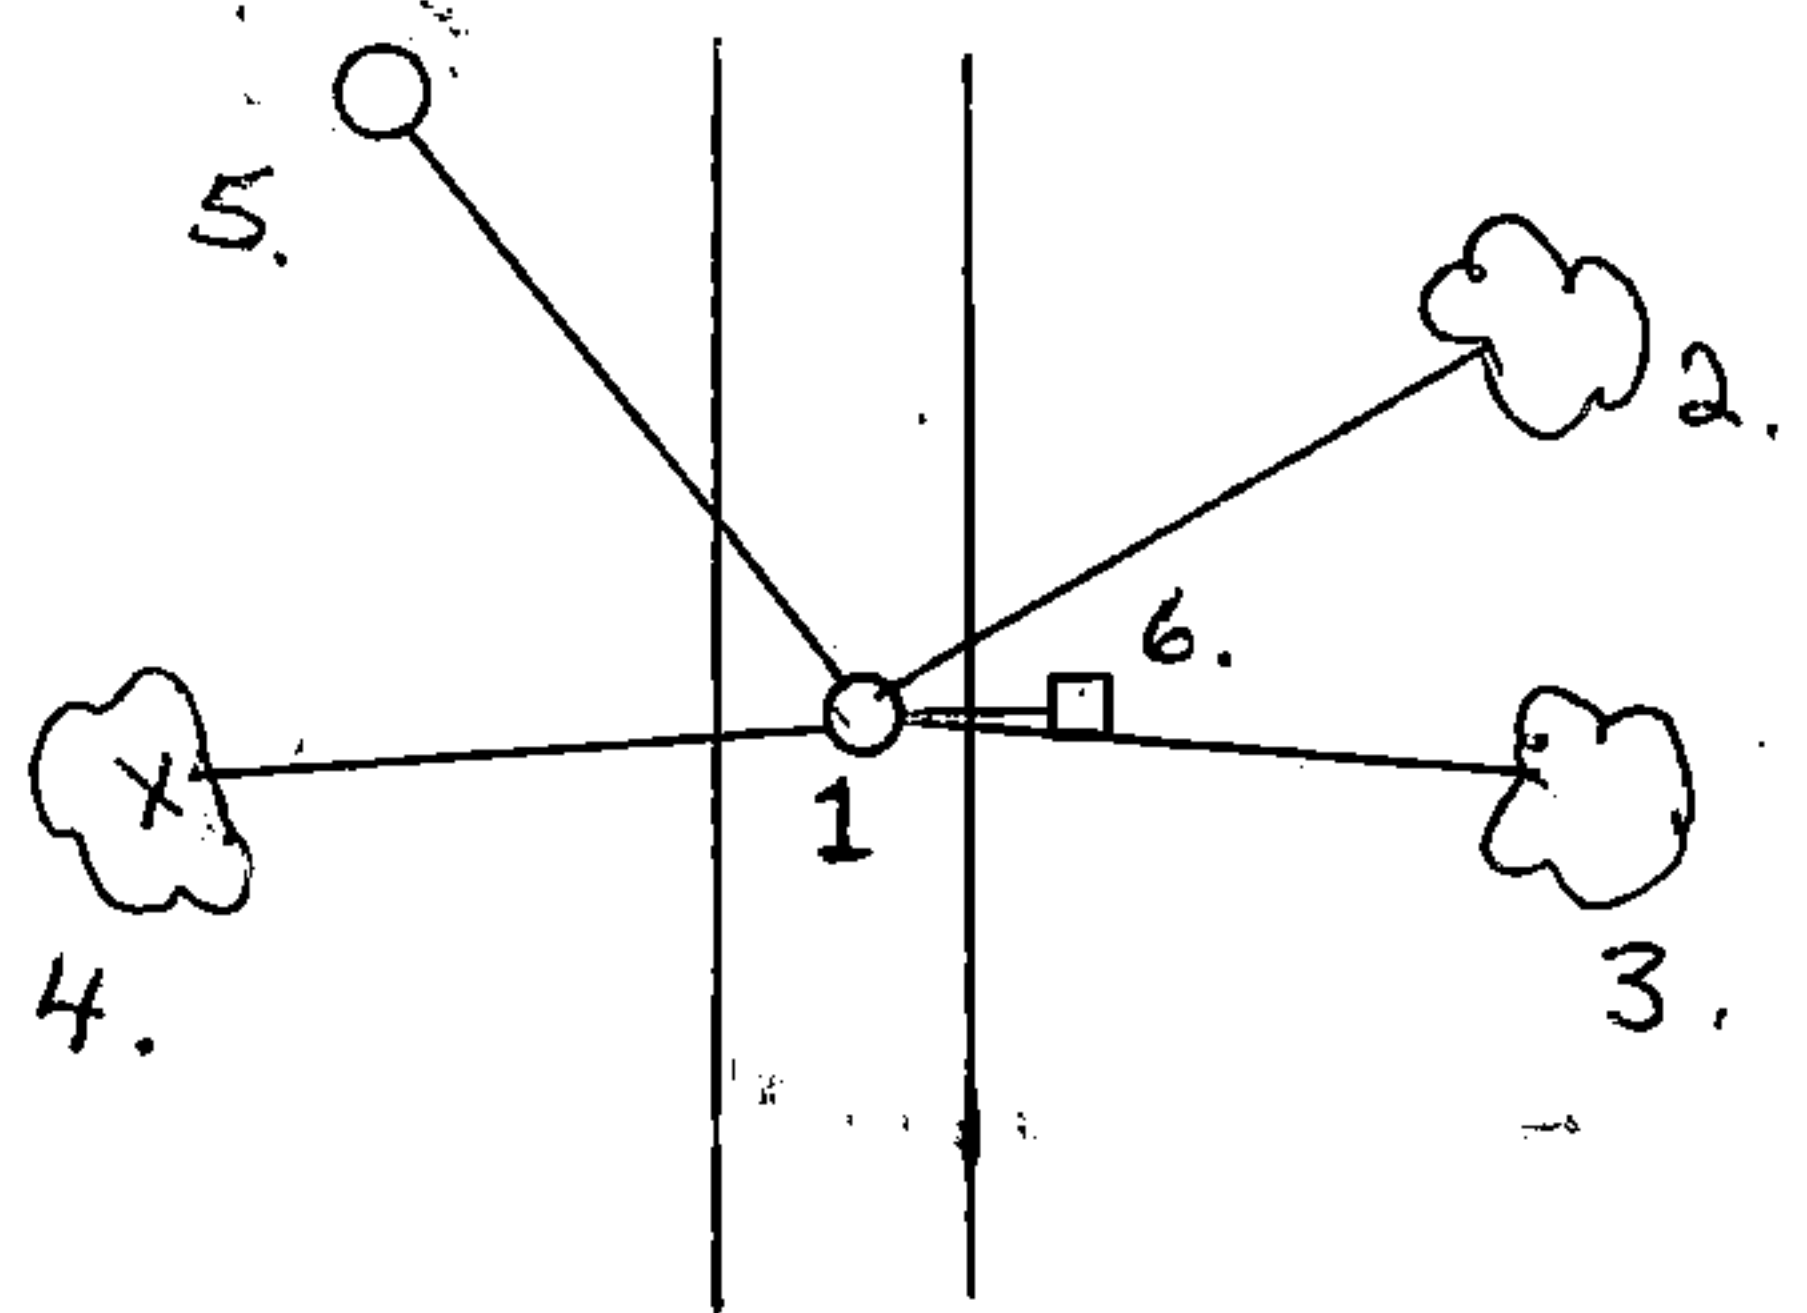

- (e) Describe any material discrepancy between the location of the corner as restored or reestablished and the location of that corner as previously restored or reestablished, by distance and direction. Show the discrepancy on the plan view drawing under (d), above. Show the distances between the corner as previously restored or reestablished and (1) the corner as restored or reestablished, and (2) to at least 2 of the witness monuments shown on the drawing in (d), above.

None.

- (f) Was the corner restored through acceptance of (1) an obliterated evidence location, or, (2) a found perpetuated location?

(2) a found perpetuated location.

- (g&h) Was the corner reestablished through lost corner proportionate methods? If so, show the method, including the directions and distances to other public land survey corners used as evidence or used for proportioning in determining the corner location?

- (i) I, Alan D. Harrison
(type or print name) certify that the corner location shown on this record was determined by me or under my direction and control and that this U.S. Public Land Survey Monument Record is correct and complete to the best of my knowledge and belief.

Alan D. Harrison 11/14/86
Signature Date

