


# U. S. PUBLIC LAND SURVEY MONUMENT RECORD

**I N S T R U C T I O N S :** This record shall show the location of the corner and shall include all of the following nine elements (a through i).

- (a) Identify the corner by reference to the U.S. public land survey system.  
 ○ = Corner monument restored.

Section corner to Sections 22, 23, 26, and 27,  
 T.38N., R.13E.

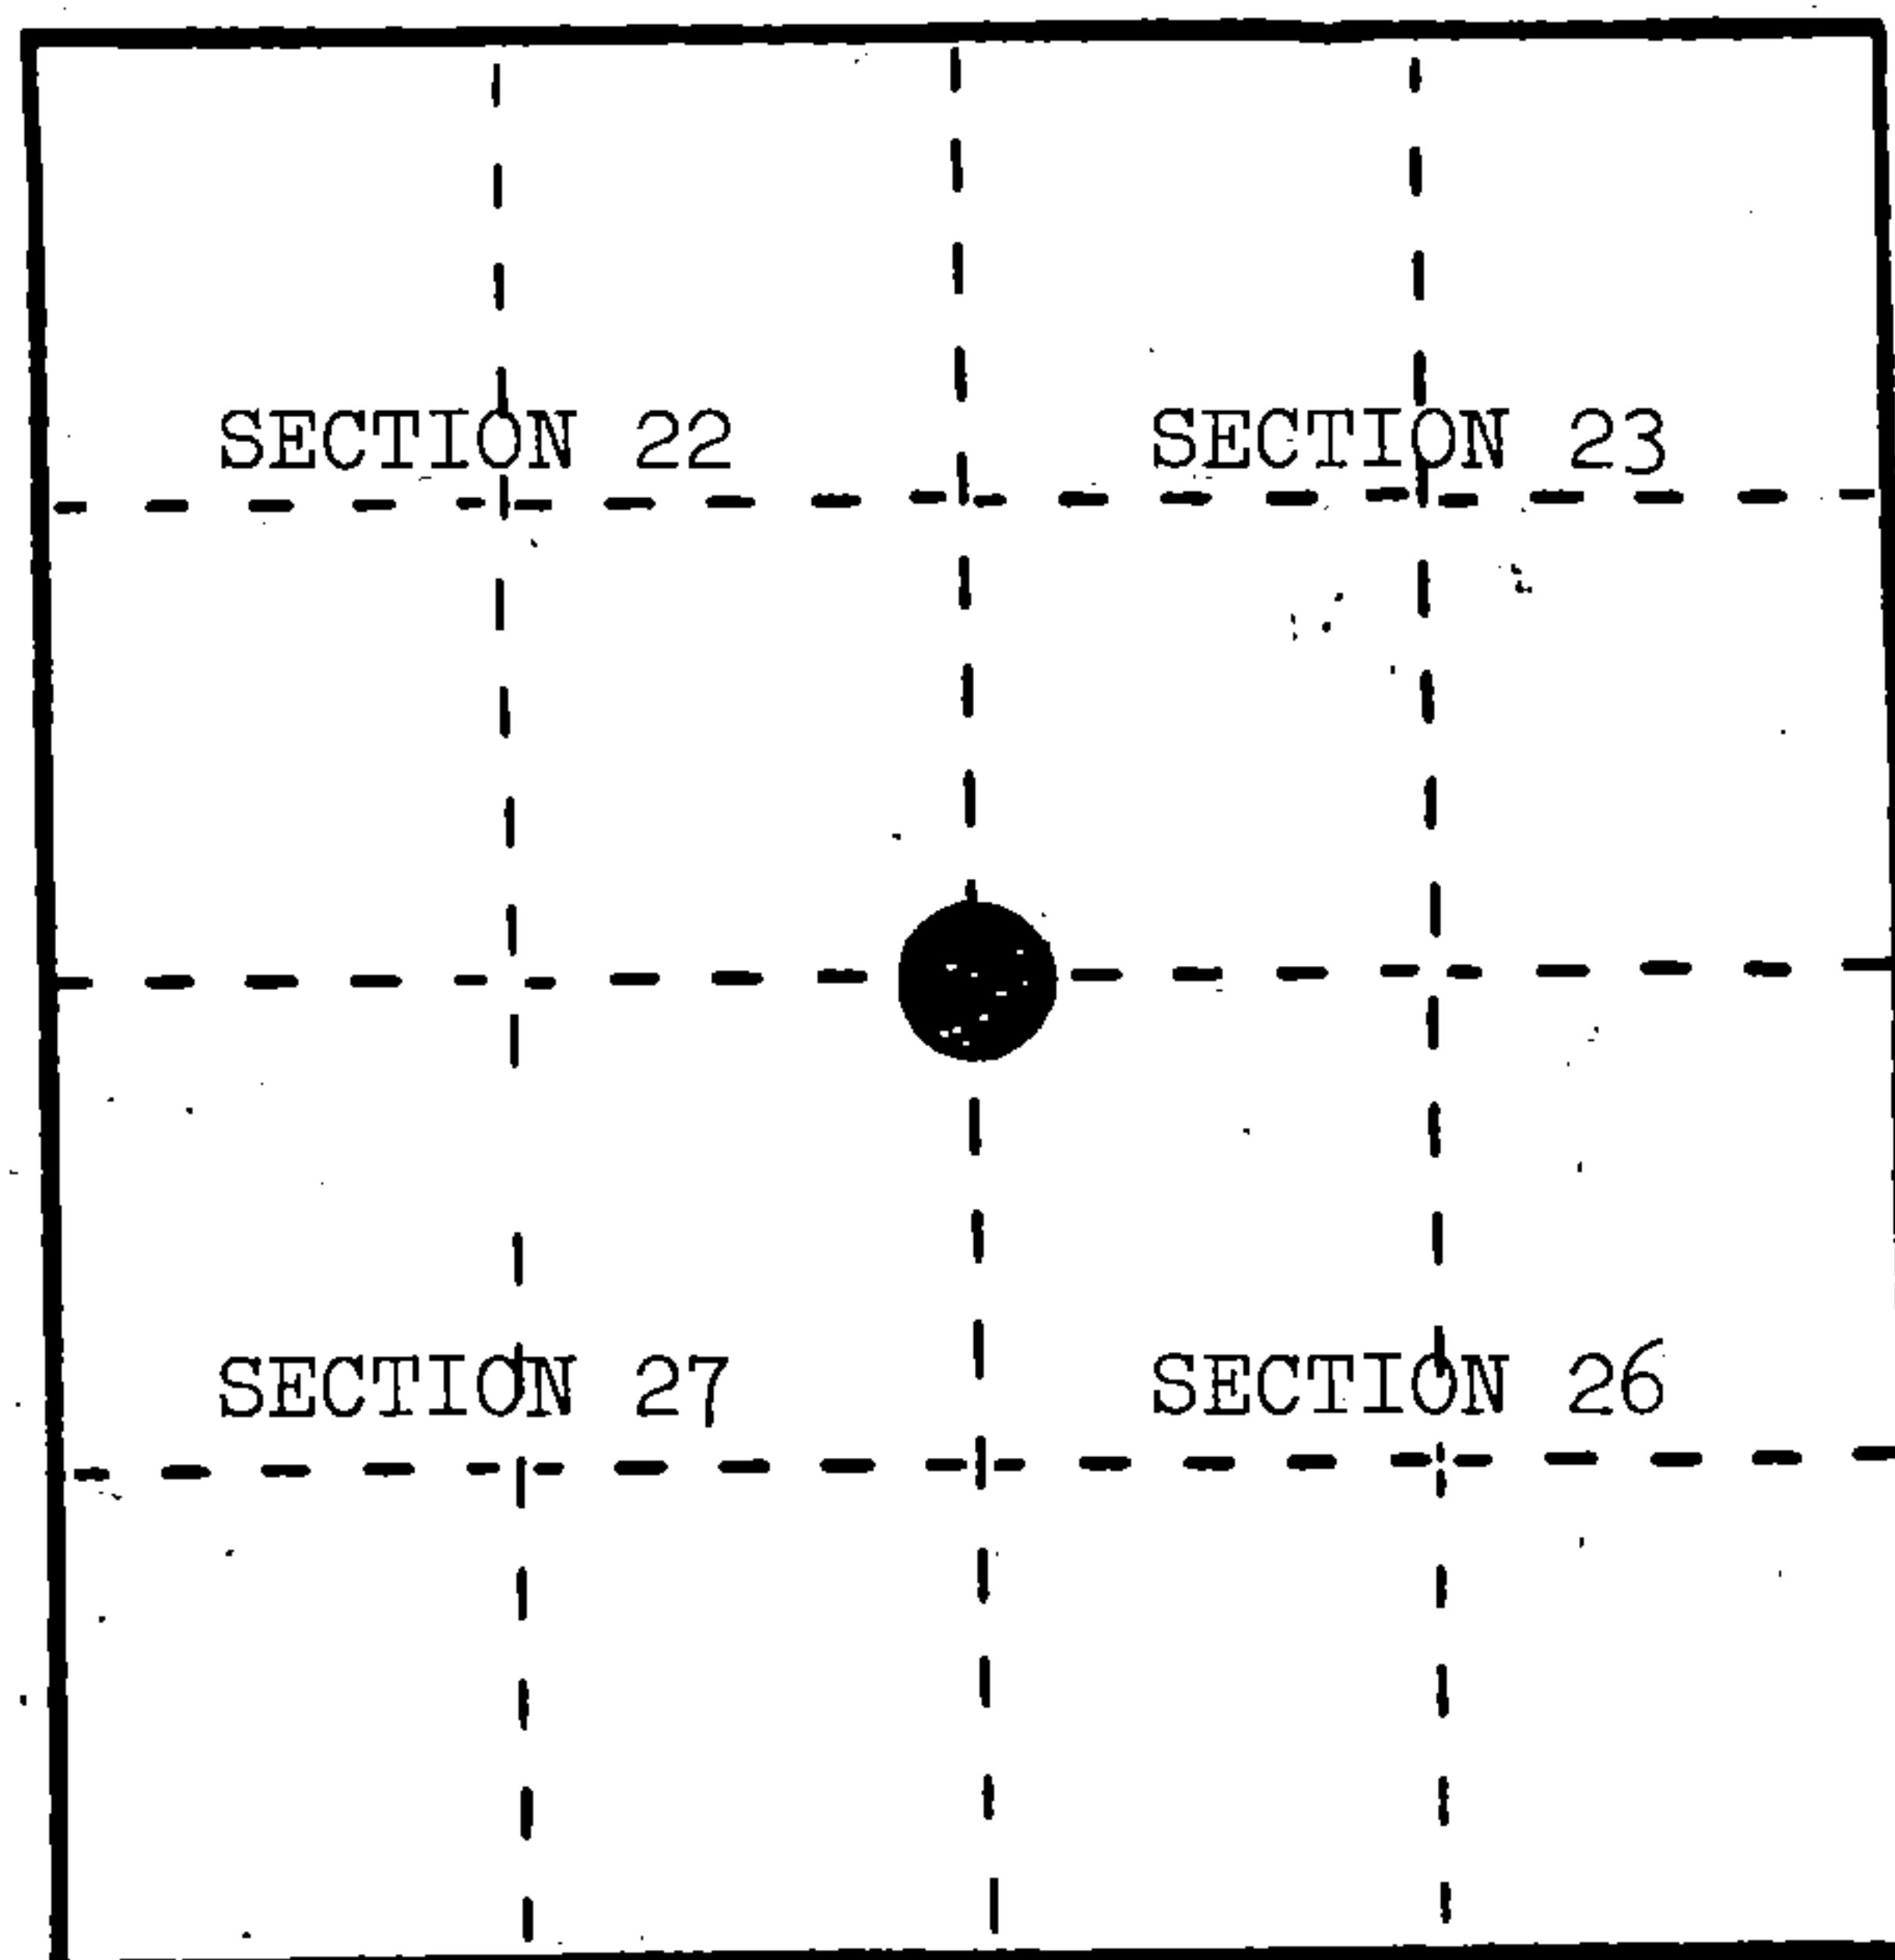

- (b) Describe any record evidence, monument evidence, occupational evidence, testimonial evidence or any other material evidence you considered, and whether the monument was found or placed.

In 1865, H. Nowlin and J. L. Nowlin set section corner post with the following BTs:  
 Cedar, 10", N.37°E., 23 links; Cedar, 10", N.18°W., 31 links.


When Highway 55 was constructed, they stated they had this corner.

May 30, 1984, Milo Stefan found location poster on east side of highway. Excavated highway to below marsh along centerline. Found no trace of post. Accepted location poster and centerline of highway as the best evidence of corner position. Corner position marked by a railroad spike in centerline of Highway 55.

- (c) In the plan view drawing below, provide reference ties to at least 4 witness monuments, or, if the location is within a municipality, to at least 2 witness monuments. (Witness monuments shall be made of concrete, natural stone, iron or other equally durable material.)  
 Describe witness monuments.

- (d) Show a plan view drawing depicting the relevant monuments and reference ties which is sufficient in detail to enable accurate relocation of the corner monument if the corner monument is disturbed. Indicate north.

1. Black Ash, 5", N.40°E., 76.29'
2. Hemlock, 12", S.65°E., 57.00'
3. Cedar, 5", S.34°W., 79.82'
4. Cedar, 7", N.65°W., 77.59'
5. Steel Sign Post, East, 24.75'
6. 2" x 60" aluminum reference monument, East, 23.72'
7. Railroad spike marking corner location.

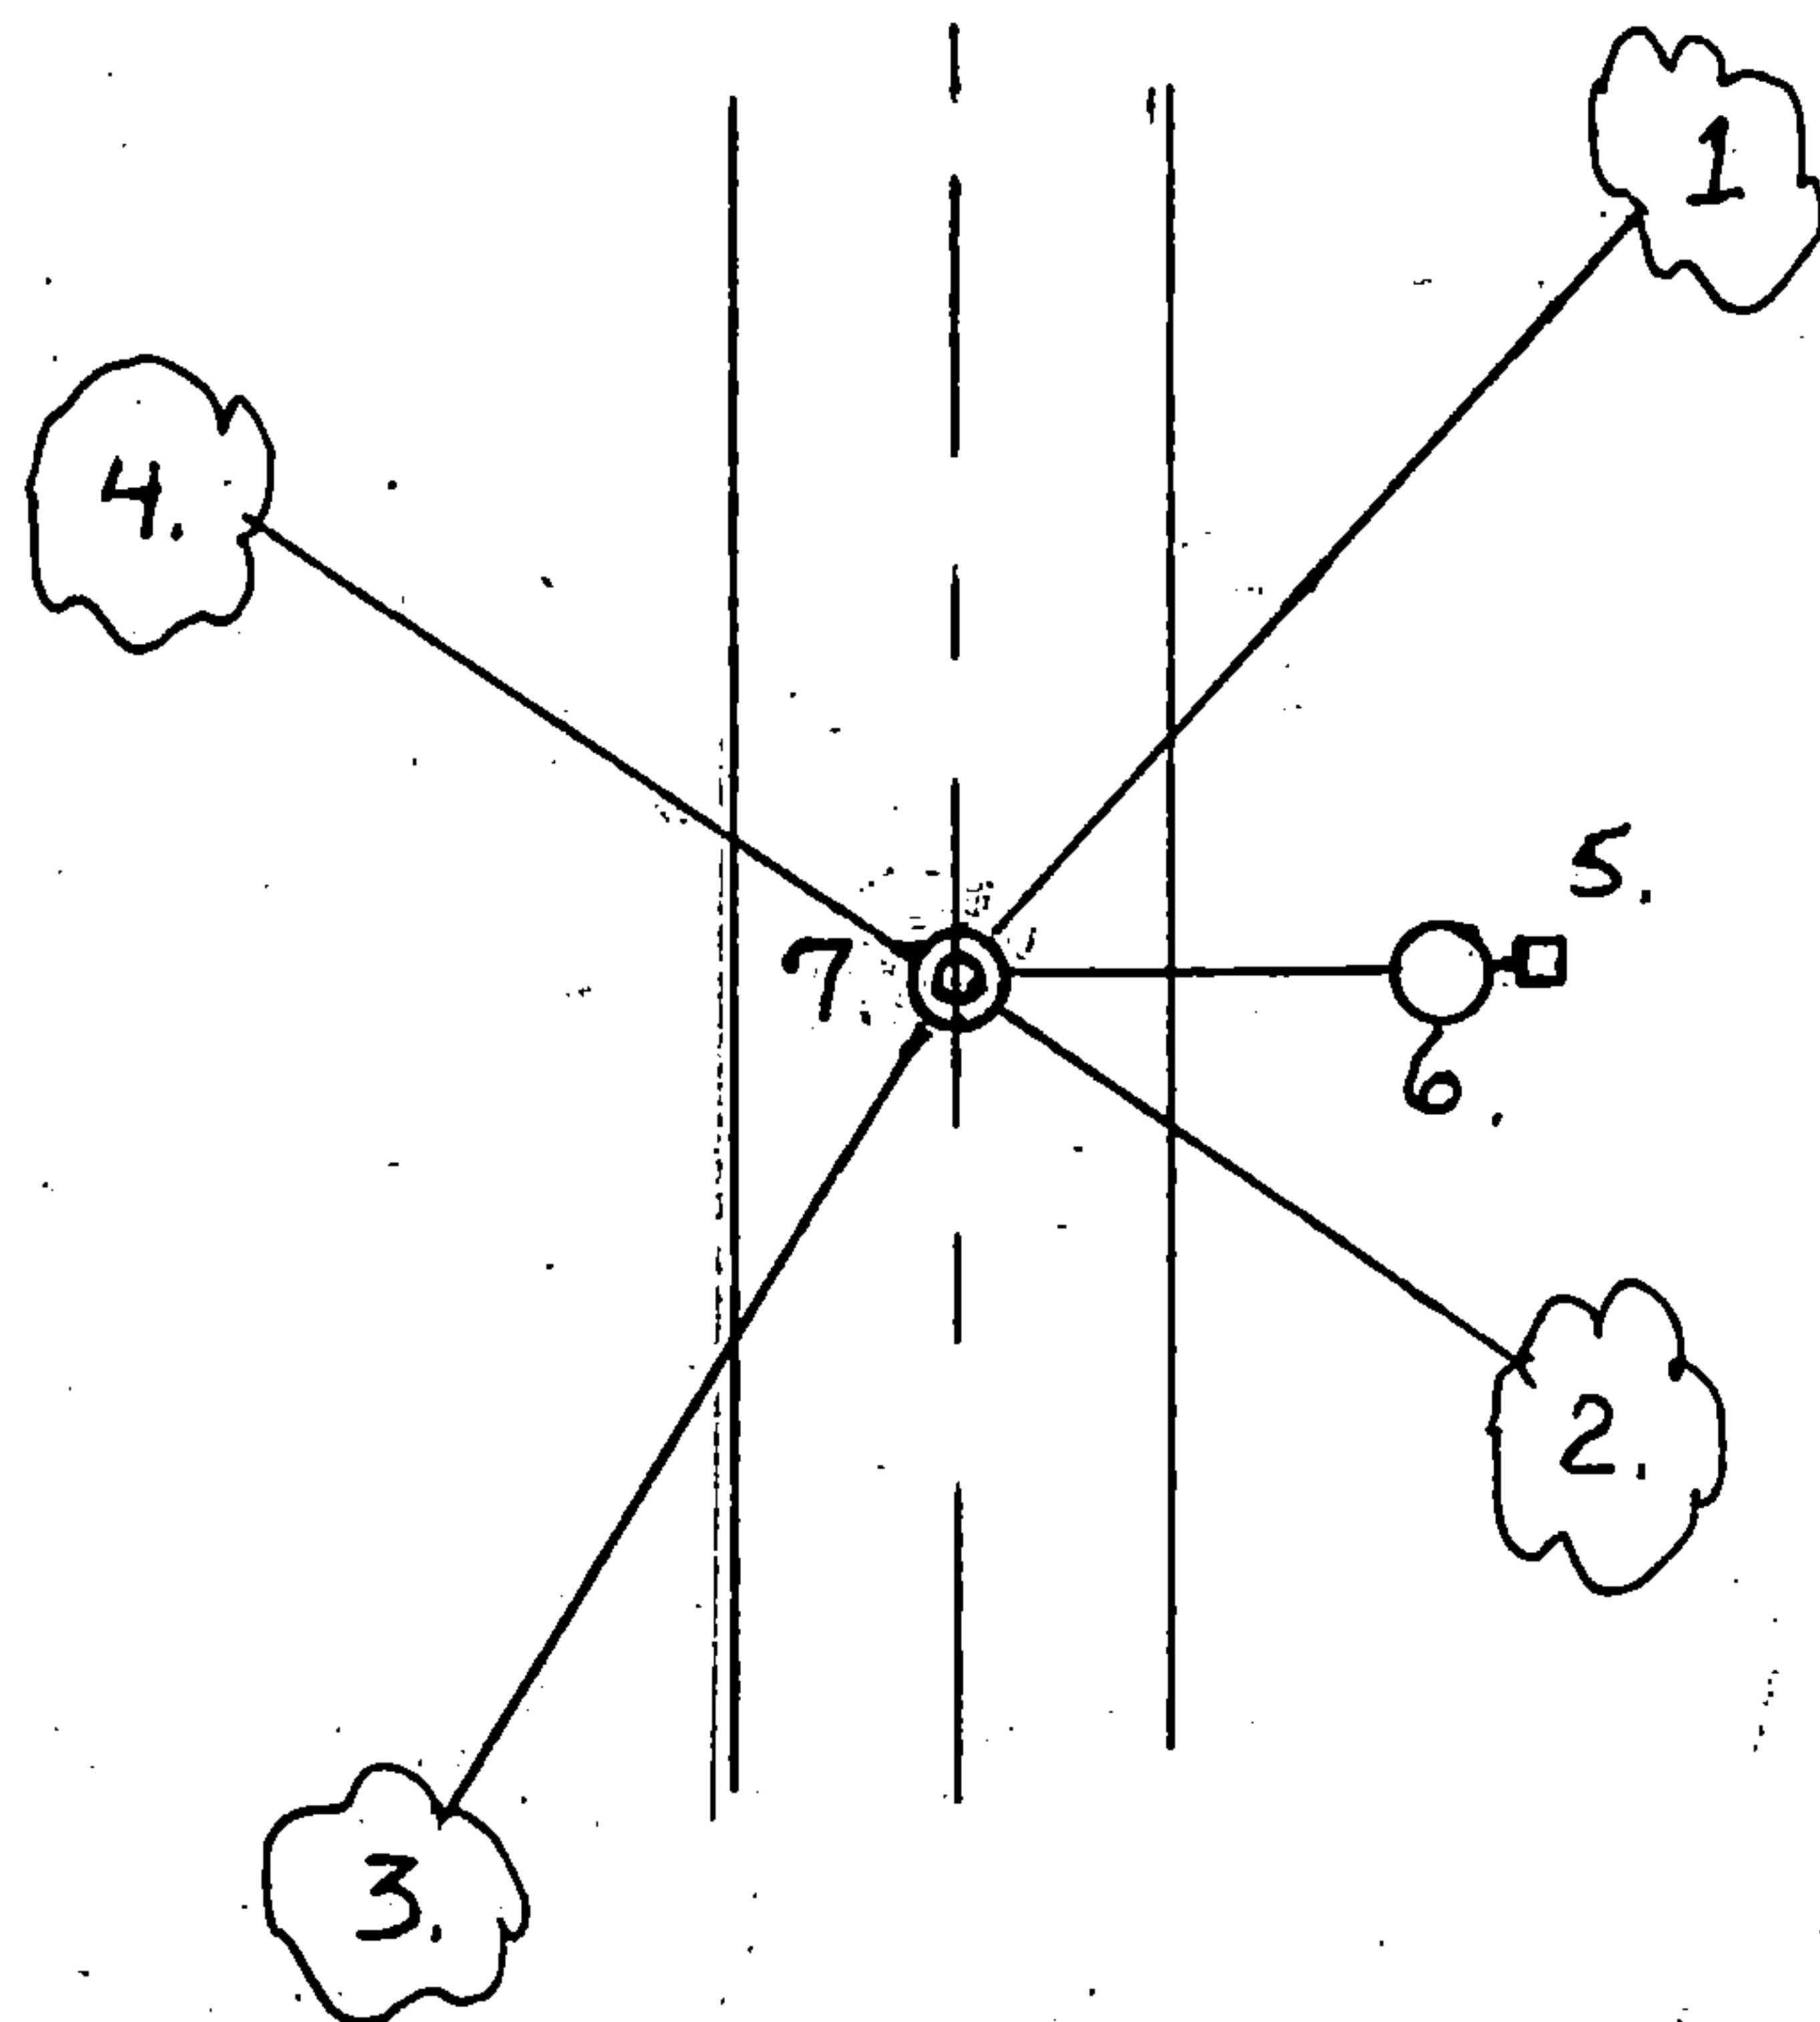

REGISTER'S OFFICE  
 Forest County, Wis.

Received for record this 23rd day  
 of January, A. D., 1985 at  
9:00 o'clock A. M. and

recorded in Vol. CORNER RESTORATION  
 on page R-17

Paul Aschenbrenner  
 REGISTER

T38-13

43813220000

R-17

R17

(e) Describe any material discrepancy between the location of the corner as restored or reestablished and the location of that corner as previously restored or reestablished by distance and direction. Show the discrepancy on the plan view drawing under (d), above. Show the distances between the corner as previously restored or reestablished and (1) the corner as restored or reestablished, and (2) to at least 2 of the witness monuments shown on the drawing in (d), above.

(f) Was the corner restored through acceptance of (1) an obliterated evidence location, or, (2) a found perpetuated location?

(1) an obliterated evidence location.

(g&h) Was the corner reestablished through lost corner proportionate methods? If so, show the method, including the directions and distances to other public land survey corners used as evidence or used for proportioning in determining the corner location?

No.

(i) Milo E. Stefan

(Type or print name) certify that the corner location shown on this record was determined by me or under my direction and control and that this U.S. Public Land Survey Monument Record is correct and complete to the best of my knowledge and belief.

Milo E. Stefan  
Signature

12/24/84  
Date

Affix Land Surveyor Seal

