
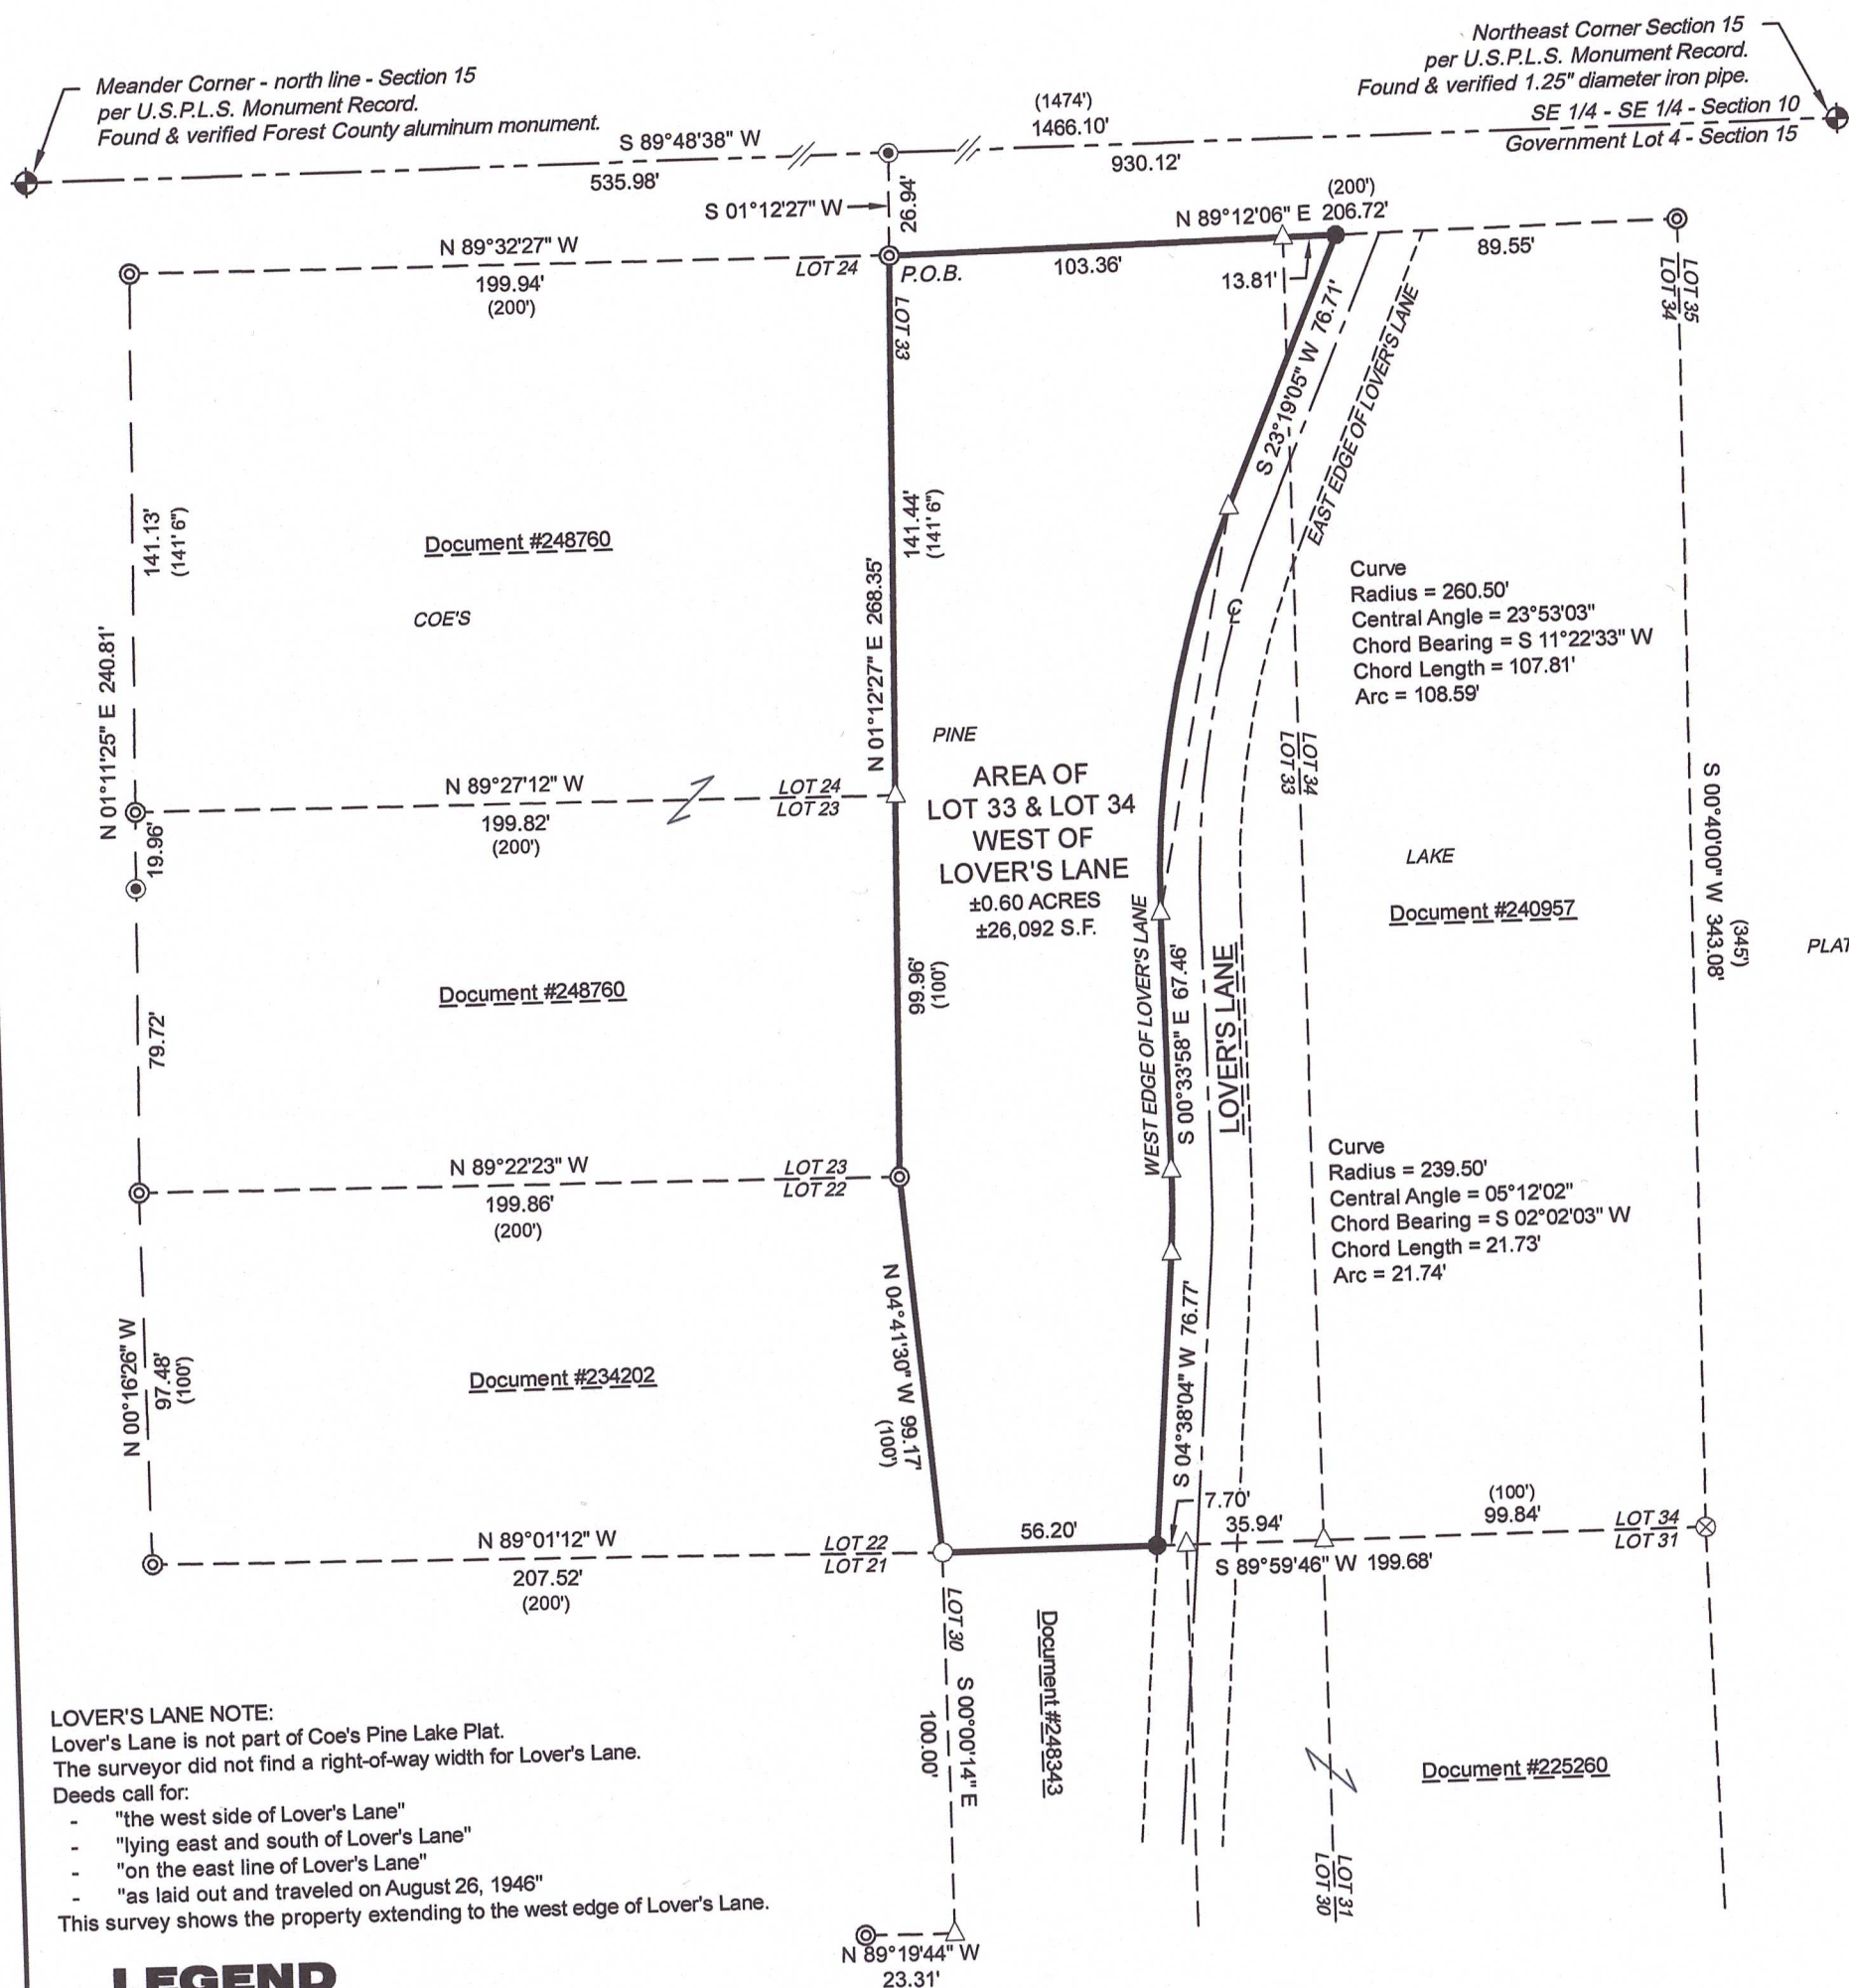


PART OF THOSE LANDS DESCRIBED IN DOCUMENT NUMBER 234202
BEING PART OF LOT 33 AND PART OF LOT 34 OF COE'S PINE LAKE PLAT,
RECORDED AS DOCUMENT #36157, IN VOLUME 1 OF PLATS ON PAGE 44,
BEING PART OF GOVERNMENT LOT 4, SECTION 15, TOWNSHIP 37 NORTH,
RANGE 12 EAST, FOURTH PRINCIPAL MERIDIAN,
TOWN OF HILES, FOREST COUNTY, WISCONSIN

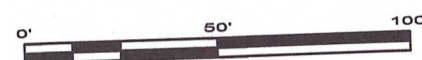

LOVER'S LANE NOTE:
 Lover's Lane is not part of Coe's Pine Lake Plat.
 The surveyor did not find a right-of-way width for Lover's Lane.
 Deeds call for:

- "the west side of Lover's Lane"
 - "lying east and south of Lover's Lane"
 - "on the east line of Lover's Lane"
 - "as laid out and traveled on August 26, 1946"
- This survey shows the property extending to the west edge of Lover's Lane.

Monument sizes = outside diameter measurements.

- 0.75" diameter X 18" long iron rod, weighing 1.5 lbs. per lineal foot, set
- ◎ 1.25" diameter iron pipe, found
- ⊙ 1" diameter iron pipe, found
- ⊗ 1.6" diameter iron pipe, found
- 1.5" diameter iron pipe, found
- ⊕ U.S.P.L.S. monument, as noted
- △ Computed position, not set
- () Previously recorded data
- Ⓢ Centerline

P.O.B. Point of Beginning

U.S.P.L.S. United States Public Land Survey

S.F. Square feet

FOREST CO SURVEYOR
FILE # 371215-20260803
DATE 08/03/2026 BY SA

Jeffrey L. DeMuth S-2656

See Sheet 2 of 2 Sheets for property description and Certificates.

August 3, 2026
Date

Project : 2026-16-Slaats Survey
 Drawn by: Jeffrey L. DeMuth
 Checked by: James E. Anderson
 Fieldwork completed: July 2026
 Sheet 1 of 2 Sheets

CLIENT:
Patrick G. & Tina M. Slaats
SITE ADDRESS:
Lovers Lane
Hiles, WI 54511

RETRACEMENT SURVEY

 cardinal North, Inc.
ENGINEERING | SURVEYING | DRONE

4327 COLE ROAD
CRANDON, WI 54520
Anderson 715.784.3485
DeMuth 715.482.5237
cardinal.north@outlook.com

SURVEYOR'S CERTIFICATE

I, Jeffrey L. DeMuth, Professional Land Surveyor S-2656 of the State of Wisconsin, do hereby certify to my client, Patrick and Tina Slaats, the Owners and under whose direction this survey was performed, that I have surveyed, mapped, and described part of those lands described in document number 234202; being part of Lot 33 and part of Lot 34 of Coe's Pine Lake Plat, recorded as document #36157, in volume 1 of plats on page 44, being part of Government Lot 4, Section 15, Township 37 North, Range 12 East, Fourth Principal Meridian, Town of Hiles, Forest County, Wisconsin.



Being more particularly described for mapping purposes as follows:

Commencing at the Northeast corner of Section 15, Thence, S 89°48'38" W, along the north line of Government Lot 4 of said section, a distance of 930.12 feet to northerly extension of the east line of Lot 24 of said plat; Thence S 01°12'27" W, along said extended east line, a distance of 26.94 feet to the northeast corner of said Lot 24 and the POINT OF BEGINNING of lands to be described;

Thence, leaving said extended east line, N 89°12'06" E, along the north line of Lot 33 and Lot 34 of said plat, a distance of 117.17 feet to the west edge of Lover's Lane; Thence, leaving said north line, and along the west edge of said Lover's Lane the following courses: S 23°19'05" W, a distance of 76.71 feet to the point of curvature of a curve to the left, having a radius of 260.50 feet, a central angle of 23°53'03", and a chord bearing and distance of S 11°22'33" W, 107.81 feet; Thence, southerly along said curve, a distance of 108.59 feet; Thence, continuing along said west edge, S 00°33'58" E, a distance of 67.46 feet, to the point of curvature of a curve to the right, having a radius of 239.50 feet, a central angle of 05°12'02", and a chord bearing and distance of S 02°02'03" W, 21.73 feet; Thence, southerly along said curve, a distance of 21.74 feet; Thence, continuing along said west edge, S 04°38'04" W, a distance of 76.77 feet to the north line of Lot 30 of Coe's Pine Lake Plat; Thence, leaving said west edge of Lover's Lane, S 89°59'46" W, along the north line of said lot, a distance of 56.20 feet to the Southeast corner of Lot 22 of said plat; Thence, leaving said north line, N 04°41'30" W, along the east line of said lot, a distance of 99.17 feet to the Southeast corner of Lot 23 of said plat; Thence, leaving said east line, N 01°12'27" E, along the east line of said Lot 23, and along the east line of Lot 24 of said plat, a distance of 214.40 feet to the Point of Beginning.

That said parcel contains 0.60 acres of land more or less and is subject to easements, restrictions, reservations, claims, and rights-of-way of record, if any.

That this Map is a true and correct representation of the exterior boundaries of lands surveyed, and that I have fully complied with Chapter A-E 7 of the Wisconsin Administrative Code, to the best of my knowledge and belief.

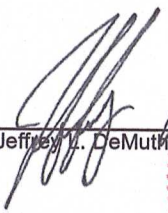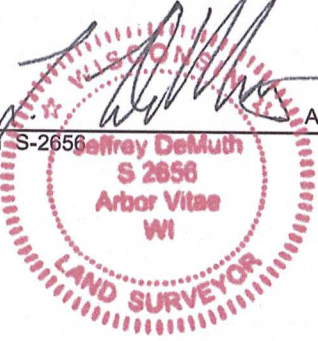
Jeffrey L. DeMuth S-2656

August 3, 2026
Date

Project : 2026-16-Slaats Survey

Drawn by: Jeffrey L. DeMuth

Checked by: James E. Anderson

Fieldwork completed: July 2026

Sheet 2 of 2 Sheets

CLIENT:
Patrick G. & Tina M. Slaats
SITE ADDRESS:
Lovers Lane
Hiles, WI 54511


cardinal North, LLC
ENGINEERING | SURVEYING | DRONE

4327 COLE ROAD
CRANDON, WI 54520
Anderson 715.784.3485
DeMuth 715.482.5237
cardinal.north@outlook.com