


430112 2000 2023

U.S. PUBLIC LAND SURVEY MONUMENT RECORD

HISTORY OF ORIGINAL CORNER ESTABLISHMENT AND SUBSEQUENT RESTORATION AND DESCRIPTION OF ANY RECORD, MONUMENT OCCUPATIONAL, TESTIMONIAL OR OTHER EVIDENCE CONSIDERED:

THE ORIGINAL CORNER WAS SET BY NEELY IN 1853 WITH THE ORIGINAL BEARING TREES OF:
8" ELM S64°W 38 LINKS
8" ELM N42°E 7 LINKS
1979 TRADEWELL SET A 3/4" IRON AT THE INTERSECTION OF THE ROAD AND THE FENCE LINE
2023 I FOUND A GEAR SPIKE AND SOME OF TRADEWELLS TIES. SET ADDITIONAL TIES

● = LOCATION OF CORNER

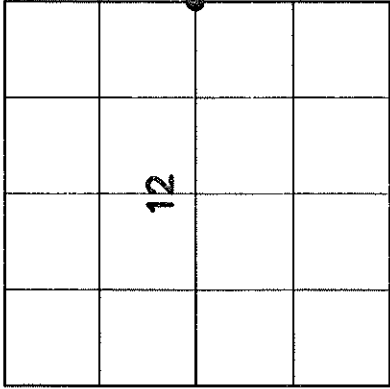


SECTION 12
TOWNSHIP 30 NORTH, RANGE 11 EAST
TOWN OF ROLLING
LANGLADE COUNTY, WISCONSIN

CORNER WAS: (CHECK ALL THAT APPLY)

- ☐ RESTORED THROUGH ACCEPTANCE OF AN OBLITERATED EVIDENCE LOCATION
- ☒ RESTORED THROUGH ACCEPTANCE OF A FOUND PERPETUATED LOCATION
- ☐ CONSIDERED A LOST CORNER AND REESTABLISHED THROUGH LOST CORNER PROPORTIONATE METHODS (INCLUDE A PLAN VIEW DRAWING SHOWING DISTANCES AND DIRECTIONS TO OTHER PUBLIC LAND SURVEY CORNERS USED FOR PROPORTIONING AND DETERMINING THE CORNER LOCATION)
- ☐ RESTORED OR REESTABLISHED IN A LOCATION THAT DIFFERS FROM A PREVIOUS RESTORATION OR REESTABLISHMENT (INCLUDE A PLAN VIEW DRAWING AND INDICATE WHAT WAS SET AND/OR FOUND)
- ☐ CHECK IF THERE IS ADDITIONAL INFORMATION ON BACK

DESCRIBE THE MONUMENT AND ACCESSORIES USED TO PERPETUATE THE LOCATION OF THE CORNER. (INCLUDE A PLAN VIEW DRAWING AND INDICATE WHAT WAS SET AND/OR FOUND) ALSO INCLUDE FOUR TIES TO THE SECTION CORNER AND DESCRIPTION OF THE TIES.

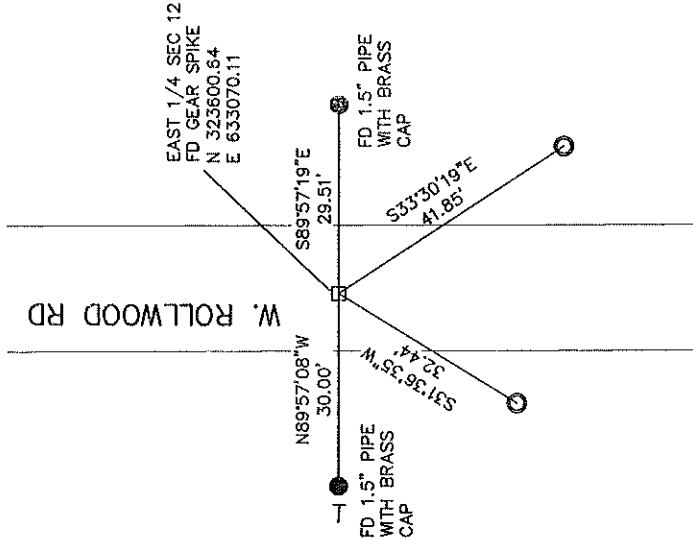

○ SET 3/4" X 30" RE-BAR WEIGHING 1.50 LBS/FT

⊙ FD 1" I. PIPE

● FD WITNESS MONUMENT

BEARINGS REFERENCED TO THE LANGLADE COUNTY COORDINATE SYSTEM

T SET 6 FOOT WHITE T-POST




CHARLEY G. BRINKMEIER

(Type or Print Name) CERTIFY THAT THE CORNER LOCATION SHOWN ON THIS RECORD WAS DETERMINED BY ME OR UNDER MY DIRECTION AND CONTROL AND THAT THIS U.S. PUBLIC LAND SURVEY MONUMENT RECORD IS CORRECT AND COMPLETE TO THE BEST OF MY KNOWLEDGE AND BELIEF.

Charley G. Brinkmeier
SIGNATURE

OCT 20 2023
DATE

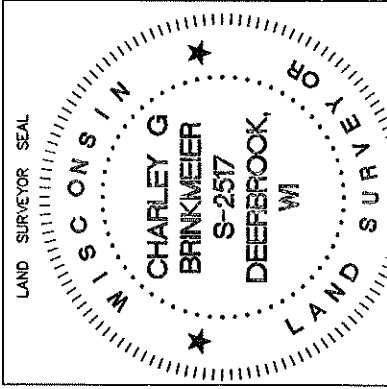

4 G25 30-11

INDEX NO.

4301112 20 00


FORM 985 H. C. MILLER CO., MILWAUKEE

State of Wisconsin }
County of LANGLADE } ss.

I WESLEY J. TRADEWELL, do hereby
certify that on the 17TH day
of MAY, 1979, I found
evidence of the WEST 1/4
corner of SECTION 7
Township 30, North, Range
12 EAST, Fourth Principal Meridian,
as described hereon; and that from this evidence
I established a new monument and accessories
as described hereon to perpetuate the original
location of this corner.

Resident witnesses:


.....
.....
.....

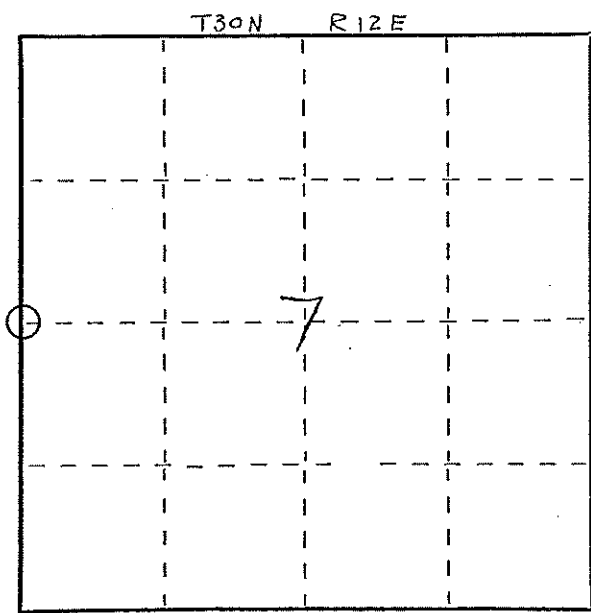

○ = Corner monument restored.

CERTIFIED LAND CORNER RESTORATION

History of original corner establishment:

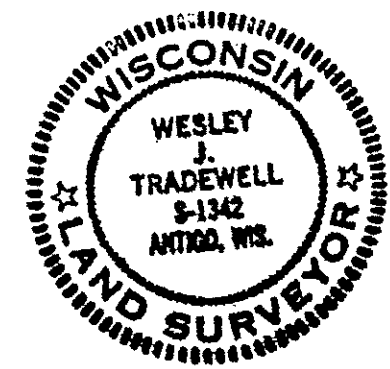


Index No. G-25
30-11

Description of corner evidence found:

CORNER OBLITERATED. SET 3/4" x 24" IRON ROD AT THE INTERSECTION OF THE CENTERLINE
OF N. ROLLWOOD RD. AND OLD FENCE TO THE WEST. CHECKED DISTANCE TO CORNERS TO
THE NORTH AND SOUTH.

Description of monument and accessories I established to perpetuate the original location of this corner.

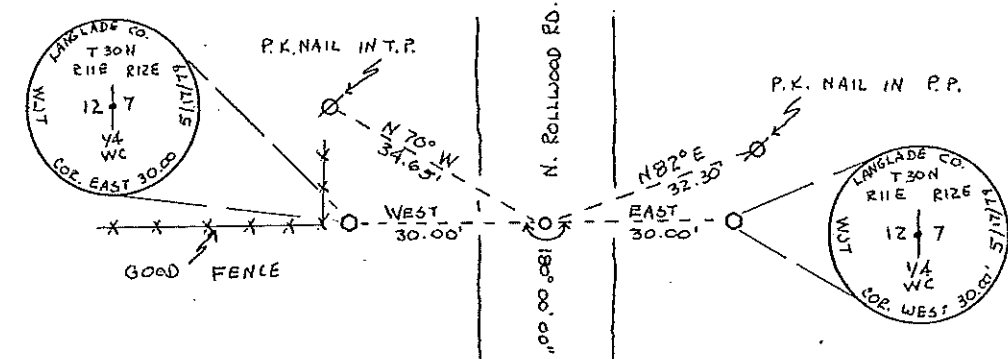

- - 1 7/8" x 42" B.I.P. w/ BRASS CAP
- - 3/4" x 24" IRON ROD SET

Dated at ANTIGO, Wis., this 18TH day of MAY, 1979.

Signature Wesley J. Tradewell Title REGISTERED LAND SURVEYOR Registration No. 1342
(County Surveyor, Registered Land Surveyor, or other duly authorized official)

Office of Register of Deeds, County of _____, I hereby certify that the within
instrument was filed in this office for record on the _____ day of _____, 19_____
at _____ o'clock _____ M.

(Register of Deeds)

By _____ Deputy

EAST QUARTER CORNER
SECTION 12, T. 30 N., R. 11 E.

06/25/97 D. Flusty

County highway department said the existing 3/4" iron rod will be disturbed in the next few days by road re-building. To save the existing position I measured to the following:

3/4" x 30" rebar set NE, 67.95', in lawn 3' west of 17" apple tree

3/4" x 30" rebar set SE, 46.18' in lawn

PK found in south side of power pole, ENE, 32.29'

Iron pipe with brass cap set by W. Tradewell, East, 29.74'

Iron pipe with brass cap set by W. Tradewell, West, 30.04'

These pipe by Tradewell were both loose. I drove them down and re-measured to them.

WARNING: DO NOT ATTEMPT TO DRIVE OR DIG IN A LONG CORNER MONUMENT
HERE, AS THERE IS A BURIED 14,400 VOLT ELECTRIC CABLE IN THE ROAD AT
THIS LOCATION!!!