

U.S. PUBLIC LAND SURVEY MONUMENT RECORD - LANGLADE COUNTY

Note: This form is intended and designed to fulfill all requirements of Wisconsin Administrative Code, Chapter A-E 7.08 U.S. Public Land Survey Monument Record (3)(a)(b)(c)(d)(e)(f)(g)(h)(i). An additional sheet may be added to if necessary to conform with said requirements.

(a) Corner Location:

Wisconsin Corner ID: 43309040000

Type of Monument: RR Spike

Location: Southeast Corner


Langlade County Coordinates NAD83(2011):

Northing: 422650.05

Easting: 566651.37

Section 4, Township 33 North, Range 9 East,
Town of Summit, Langlade County, Wisconsin

RTK GPS direct observation
Calibrated to HMP DP2802 (Summit N GPS)
3 position average on 4/25/2025

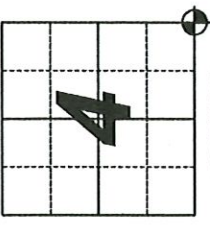

(i) I, Chad A. Besaw, Wisconsin Professional Land Surveyor #S3029, hereby certify that the corner location on this record was determined by me and that this U.S. Public Land Survey Monument Record is correct and complete to the best of my knowledge and belief.

Chad A. Besaw

Chad A. Besaw

6/6/2025


Date



- Original - 9/1860 - H.C. Fellows - Set post, made references: elm 10 N70°W - 11 links, elm 13 S31°E - 9 links.
- 7/1914 - Hutchinson FB 94 P 131, FB 122 P 68- Found original BT's, stake by Edick. hemlock 13 S84.5°E - 39.5 links, sugar 8 N7°W - 74.5 links, sugar 10 S41.5°W - 81 links.
- 1935 - Corner perpetuated in resurvey.
- 2/1938 - D.A. Hintz, Ed Vanish, Hugh St. Claire - Found a monument at corner location.
- 11/1987 - William F Kelly - Located iron buried in roadway, set new RR Spike over existing iron, set witness monuments and markers.
- 4/27/1994 - CSM V6 P12 - Todd Loftus- shows section corner found no monument description N0°32'34"W, 2643.21' to E ¼ of Sec. 4.
- 1/9/2016 - Map#10940 - Charley Brinkmeier - Found RR Spike.
- 6/19/2019 - Map#20479 - Jason Pflieger - Found RR Spike.
- 11/20/2020 - Map#20216 - Jason Pflieger - Found RR Spike.
- 11/20/2020 - Map#20216 - Jason Pflieger - Found RR Spike.
- 12/27/1987 - William F Kelly - Tie Sheet - Located iron buried in roadway, set new RR Spike over existing iron, set witness monuments and markers. Aluminum witness monument set North 45 feet, 6" blue spruce N49°E - 60.80 feet, iron pipe S65°E - 56 feet with a power pole 19.5 feet beyond, iron pipe S24°W - 60 feet with a power pole 59.75 feet beyond.

4/25/2025 - Chad Besaw - Found and accepted a RR Spike approximately 0.1 feet below road surface and 1.4 feet SW of CL intersection of County Highway "T" and County Highway "H". Found 3 of Kelly's witness ties. Distances on previous tie sheet were only to nearest foot. The SW and SE ties were found tipped and in poor condition. Accepted found RR Spike as best available corner location. Made references shown below.

(c)(d)(e) Plan view of corner with ties to at least 4 witness monuments. If in disagreement with previously established corner, show the distances between the two corners and also indicate the ties to the disputed corner.

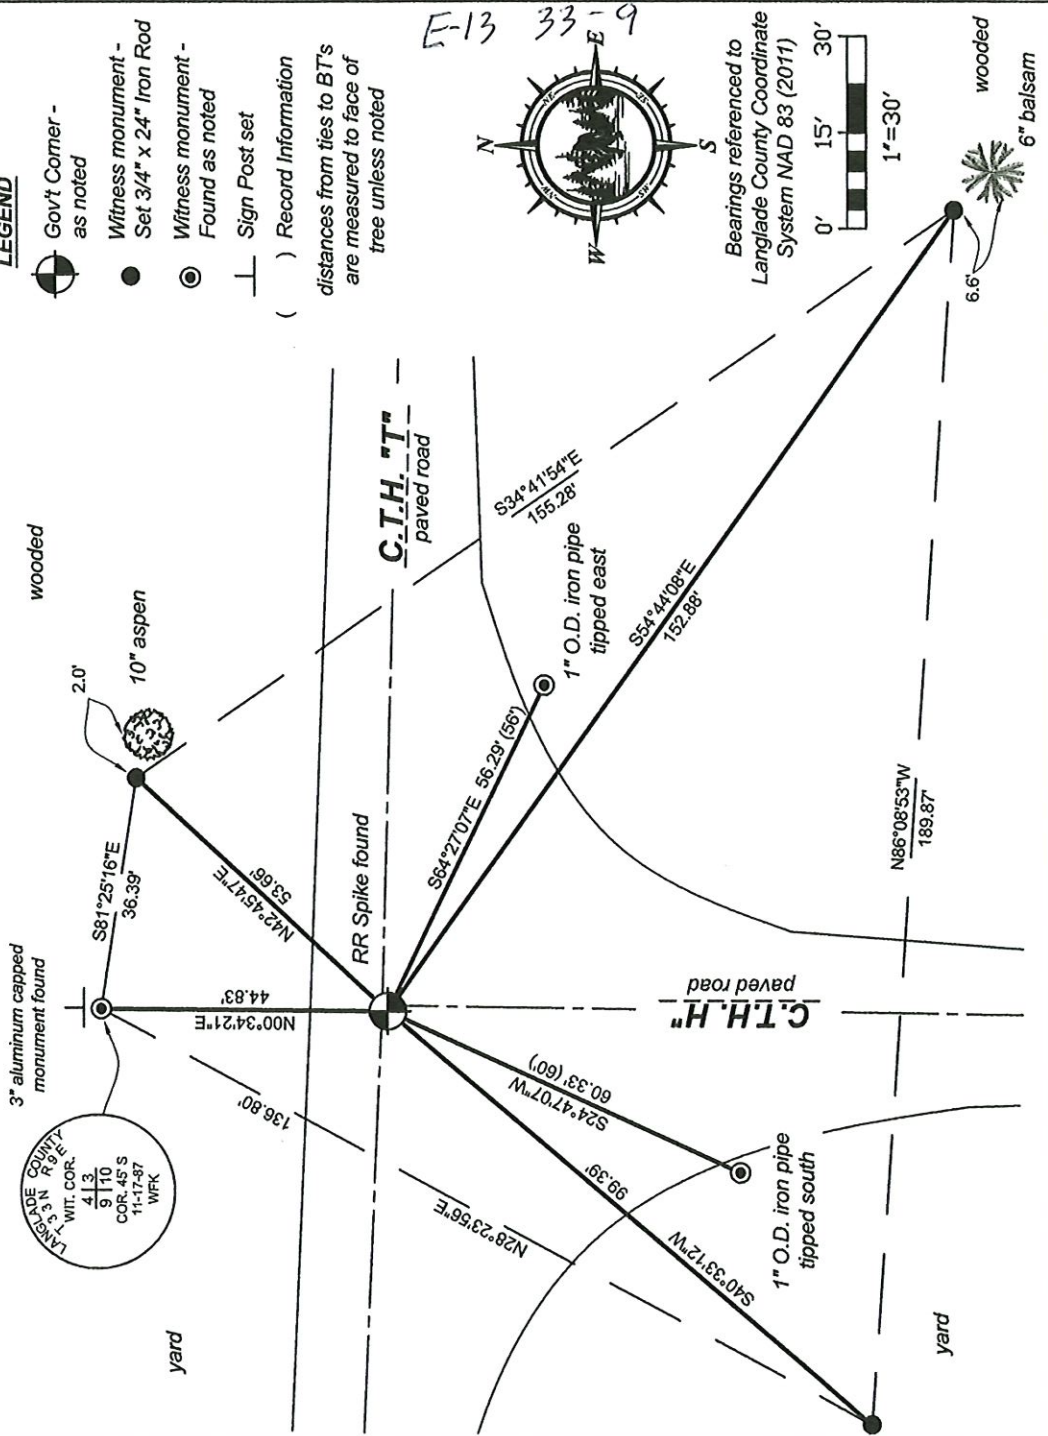

U. S. PUBLIC LAND SURVEY MONUMENT RECORD

INSTRUCTIONS:


This record shall show the location of the corner and shall include all of the following nine elements (a through i).

- (a) Identify the corner by reference to the U.S. public land survey system.

O = Corner monument restored.

ORIGINAL CORNER ESTABLISHED
BY HIRAM C. FELLOWS IN
SEPT. & OCT. 1860

CORNER PERPETUATED IN
RESURVEY IN 1935

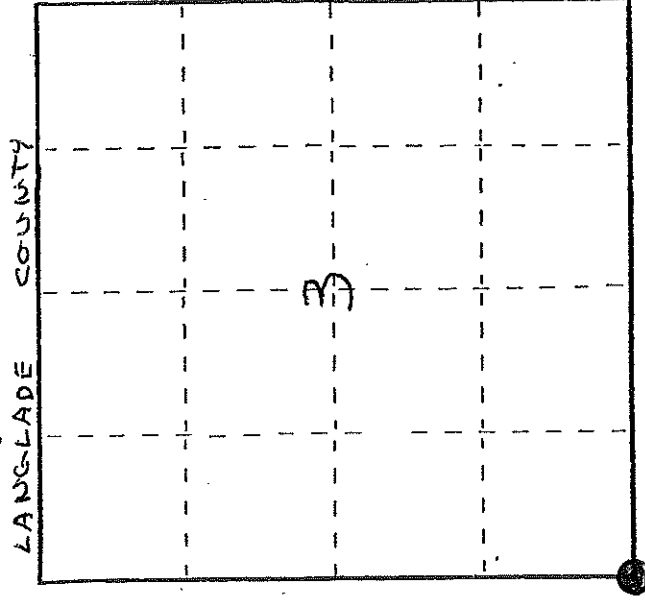


- (b) Describe any record evidence, monument evidence, occupational evidence, testimonial evidence or any other material evidence you considered, and whether the monument was found or placed.

LOCATED IRON BURIED IN ROADWAY. SET NEW R.R. SPIKE OVER
EXIST IRON. SET WIT MONUMENTS AND MARKERS

- (c) In the plan view drawing below, provide reference ties to at least 4 witness monuments, or, if the location is within a municipality, to at least 2 witness monuments. (Witness monuments shall be made of concrete, natural stone, iron or other equally durable material.) Describe witness monuments.

- (d) Show a plan view drawing depicting the relevant monuments and reference ties which is sufficient in detail to enable accurate relocation of the corner monument if the corner monument is disturbed. Indicate north.

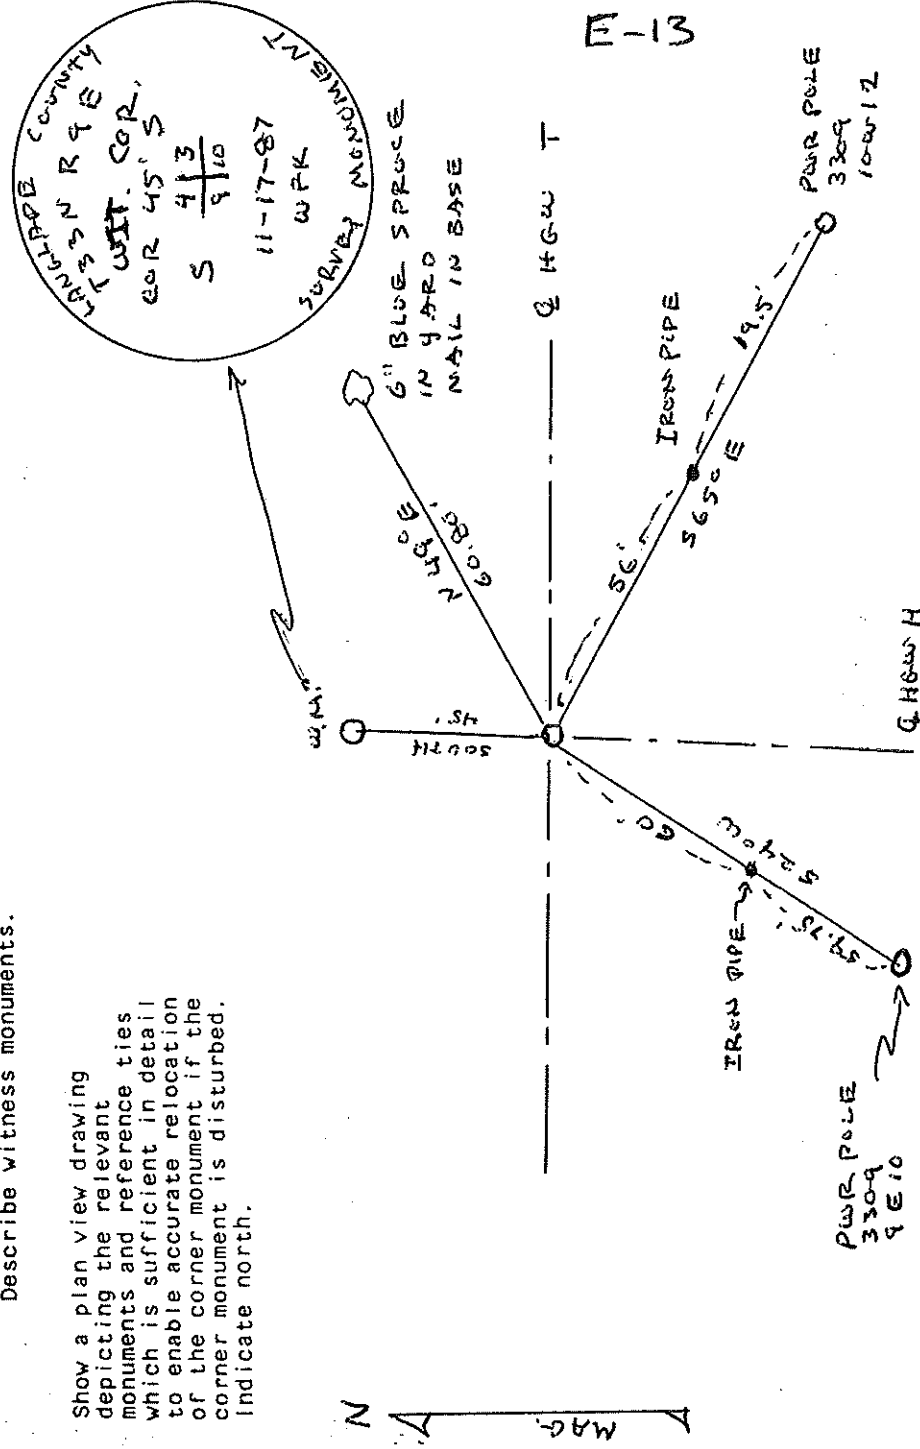

E-13

(e) Describe any material discrepancy between the location of the corner as restored or reestablished and the location of that corner as previously restored or reestablished by distance and direction. Show the discrepancy on the plan view drawing under (d), above. Show the distances between the corner as previously restored or reestablished and (1) the corner as restored or reestablished, and (2) to at least 2 of the witness monuments shown on the drawing in (d), above.

NONE

(f) Was the corner restored through acceptance of (1) an obliterated evidence location, or, (2) a found perpetuated location?

(2)

(g&h) Was the corner reestablished through lost corner proportionate methods? If so, show the method, including the directions and distances to other public land survey corners used as evidence or used for proportioning in determining the corner location?

NONE

(i) WILLIAM F. KELLY
(Type or print name) certify that the corner location shown on this record was determined by me or under my direction and control and that this U.S. Public Land Survey Monument Record is correct and complete to the best of my knowledge and belief.

Signature William F. Kelly Date 12-27-87

